


PARENT PARCEL: 16-00-077-000-007

CHILD PARCEL: 16-00-077-000-008, -009

STARTING POINT: INT. C.L. LAW ROAD & MENNELL ROAD

NO. 00146

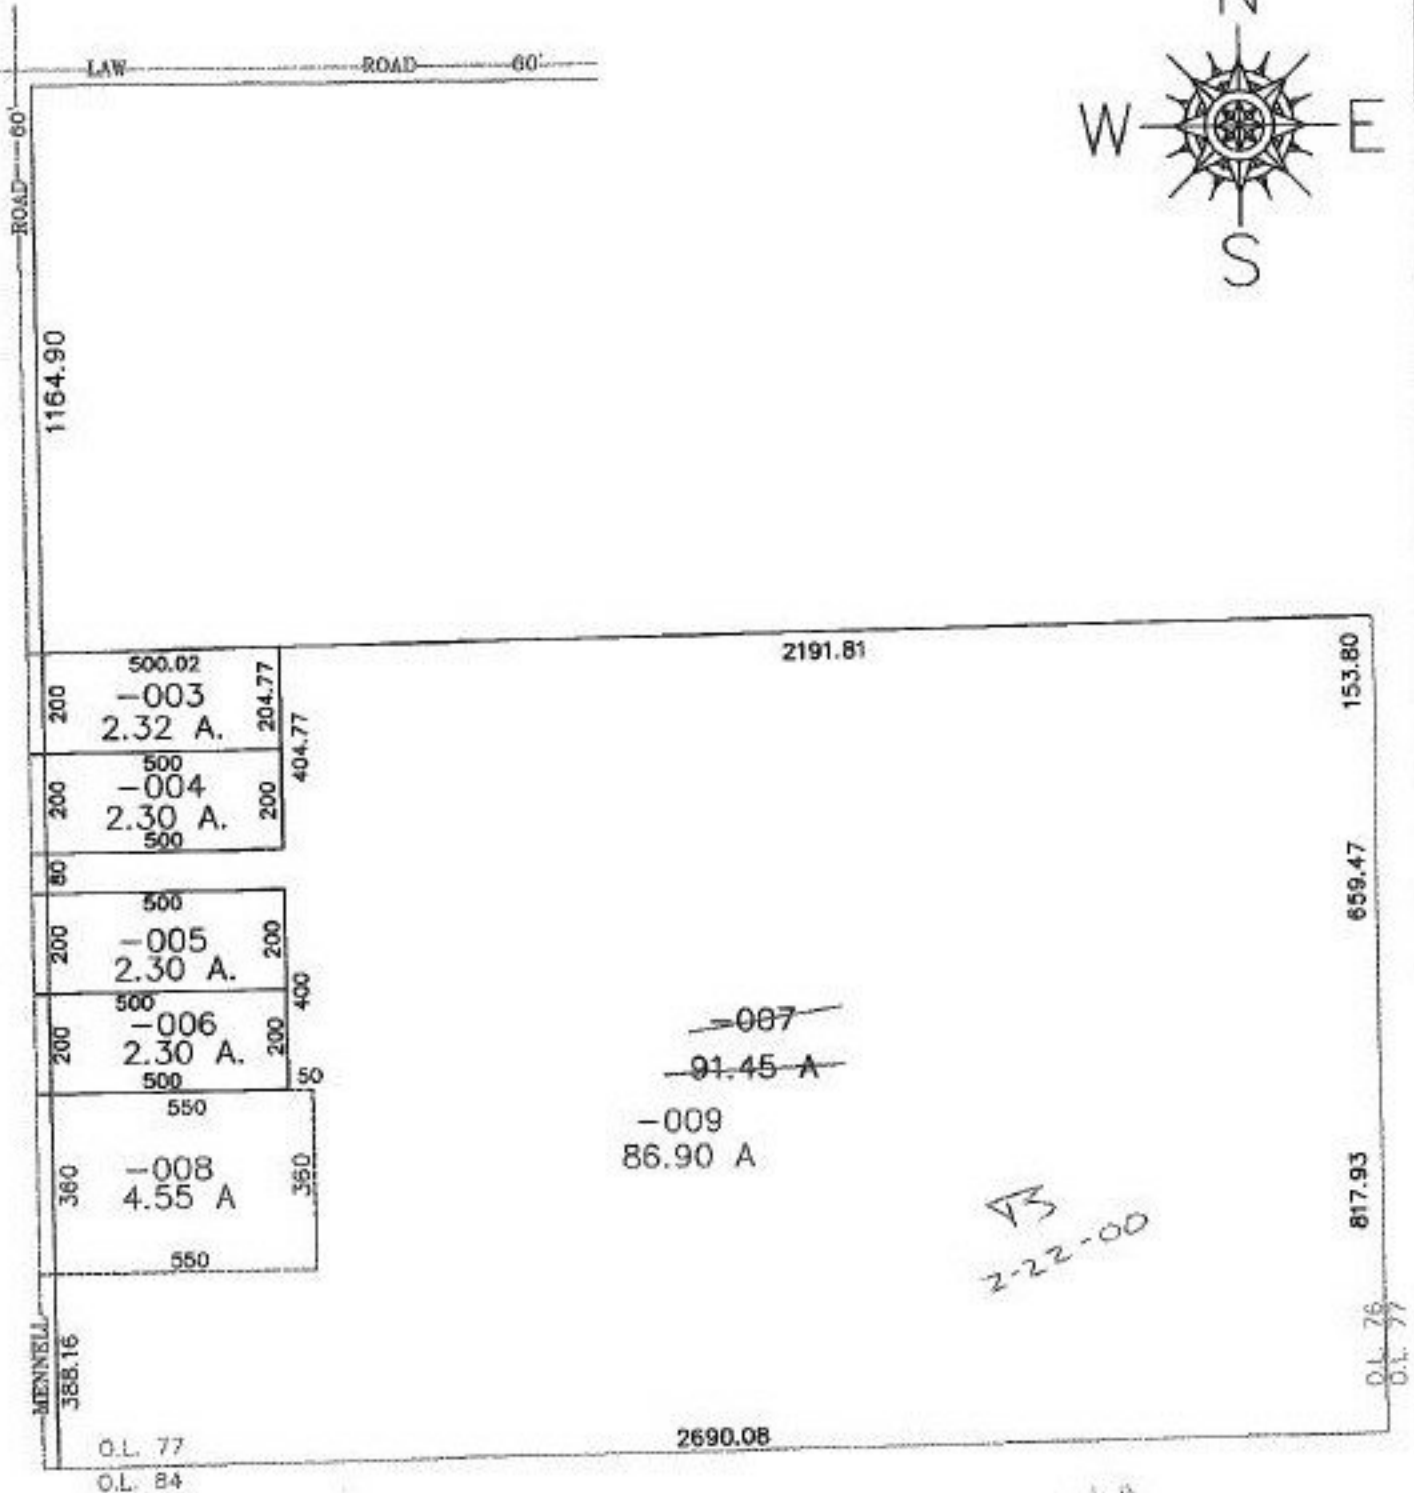

O.R. #390608666



SPLITS/DEEDS PROCESSED
LORAIN COUNTY TAX MAP DEPARTMENT
226 MIDDLE AVE. ELYRIA, OHIO

SURVEYED BY: CUNNINGHAM & ASSOC.
CLOSURE: 0.00 : 10.000
MAP PAGE(S): 16-F
APPROVED BY: DRH DATE: 7/14/99
SCALE: 1" = 400' PRIOR INSTRUMENT: