


PARENT PARCEL: 03-00-083-101-029

CHILD PARCEL: 03-00-083-101-032, -033

STARTING POINT: IP @INT OF S.L. E28TH AND E LINE TACOMA


NO. 00148

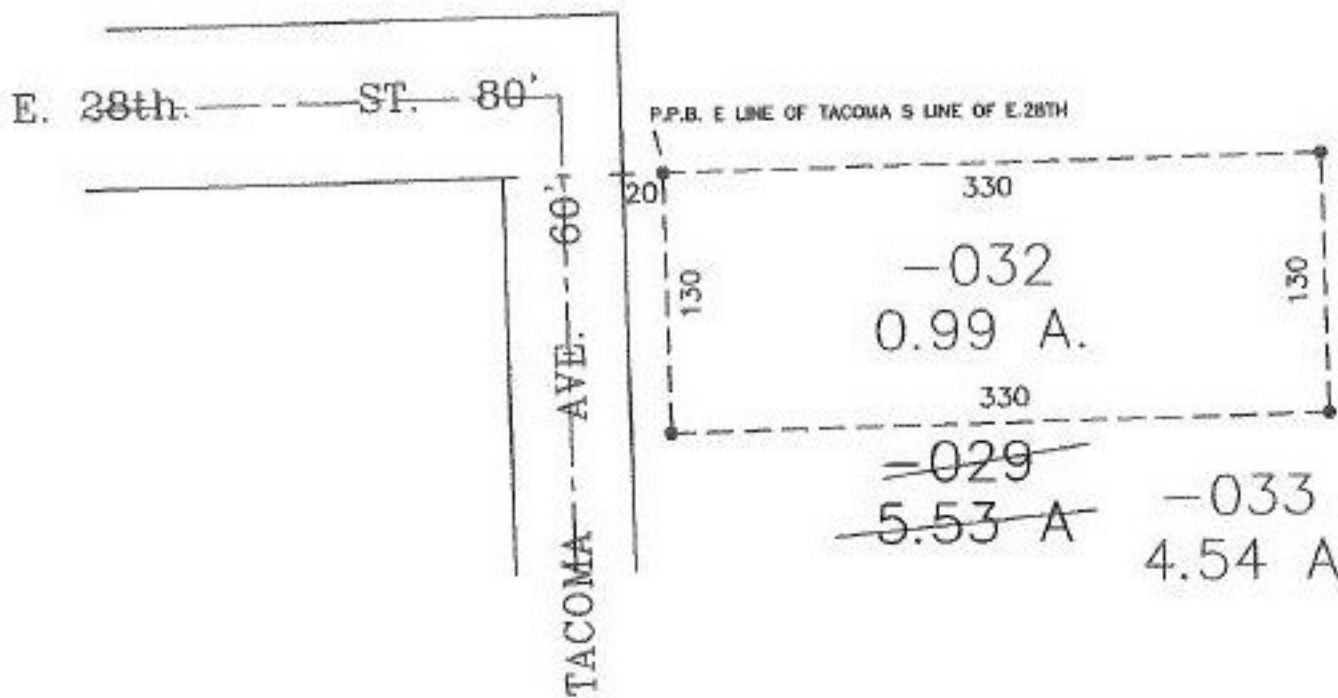

TS
9-20-99

PRIOR INSTRUMENT: DV 262/400

PRIOR INSTRUMENT: DV 19/466

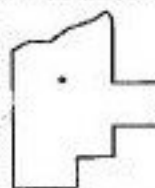

SPLITS/DEEDS PROCESSED
LORAIN COUNTY TAX MAP DEPARTMENT
226 MIDDLE AVE. ELYRIA, OHIO

SURVEYED BY: RICHARD BILSKI
CLOSURE: 0.00 : 10.000
MAP PAGE(S): 03-00-081-B
APPROVED BY: DRH DATE: 7/8/99
SCALE: 1" = 100'