


DURKEE ROAD

66

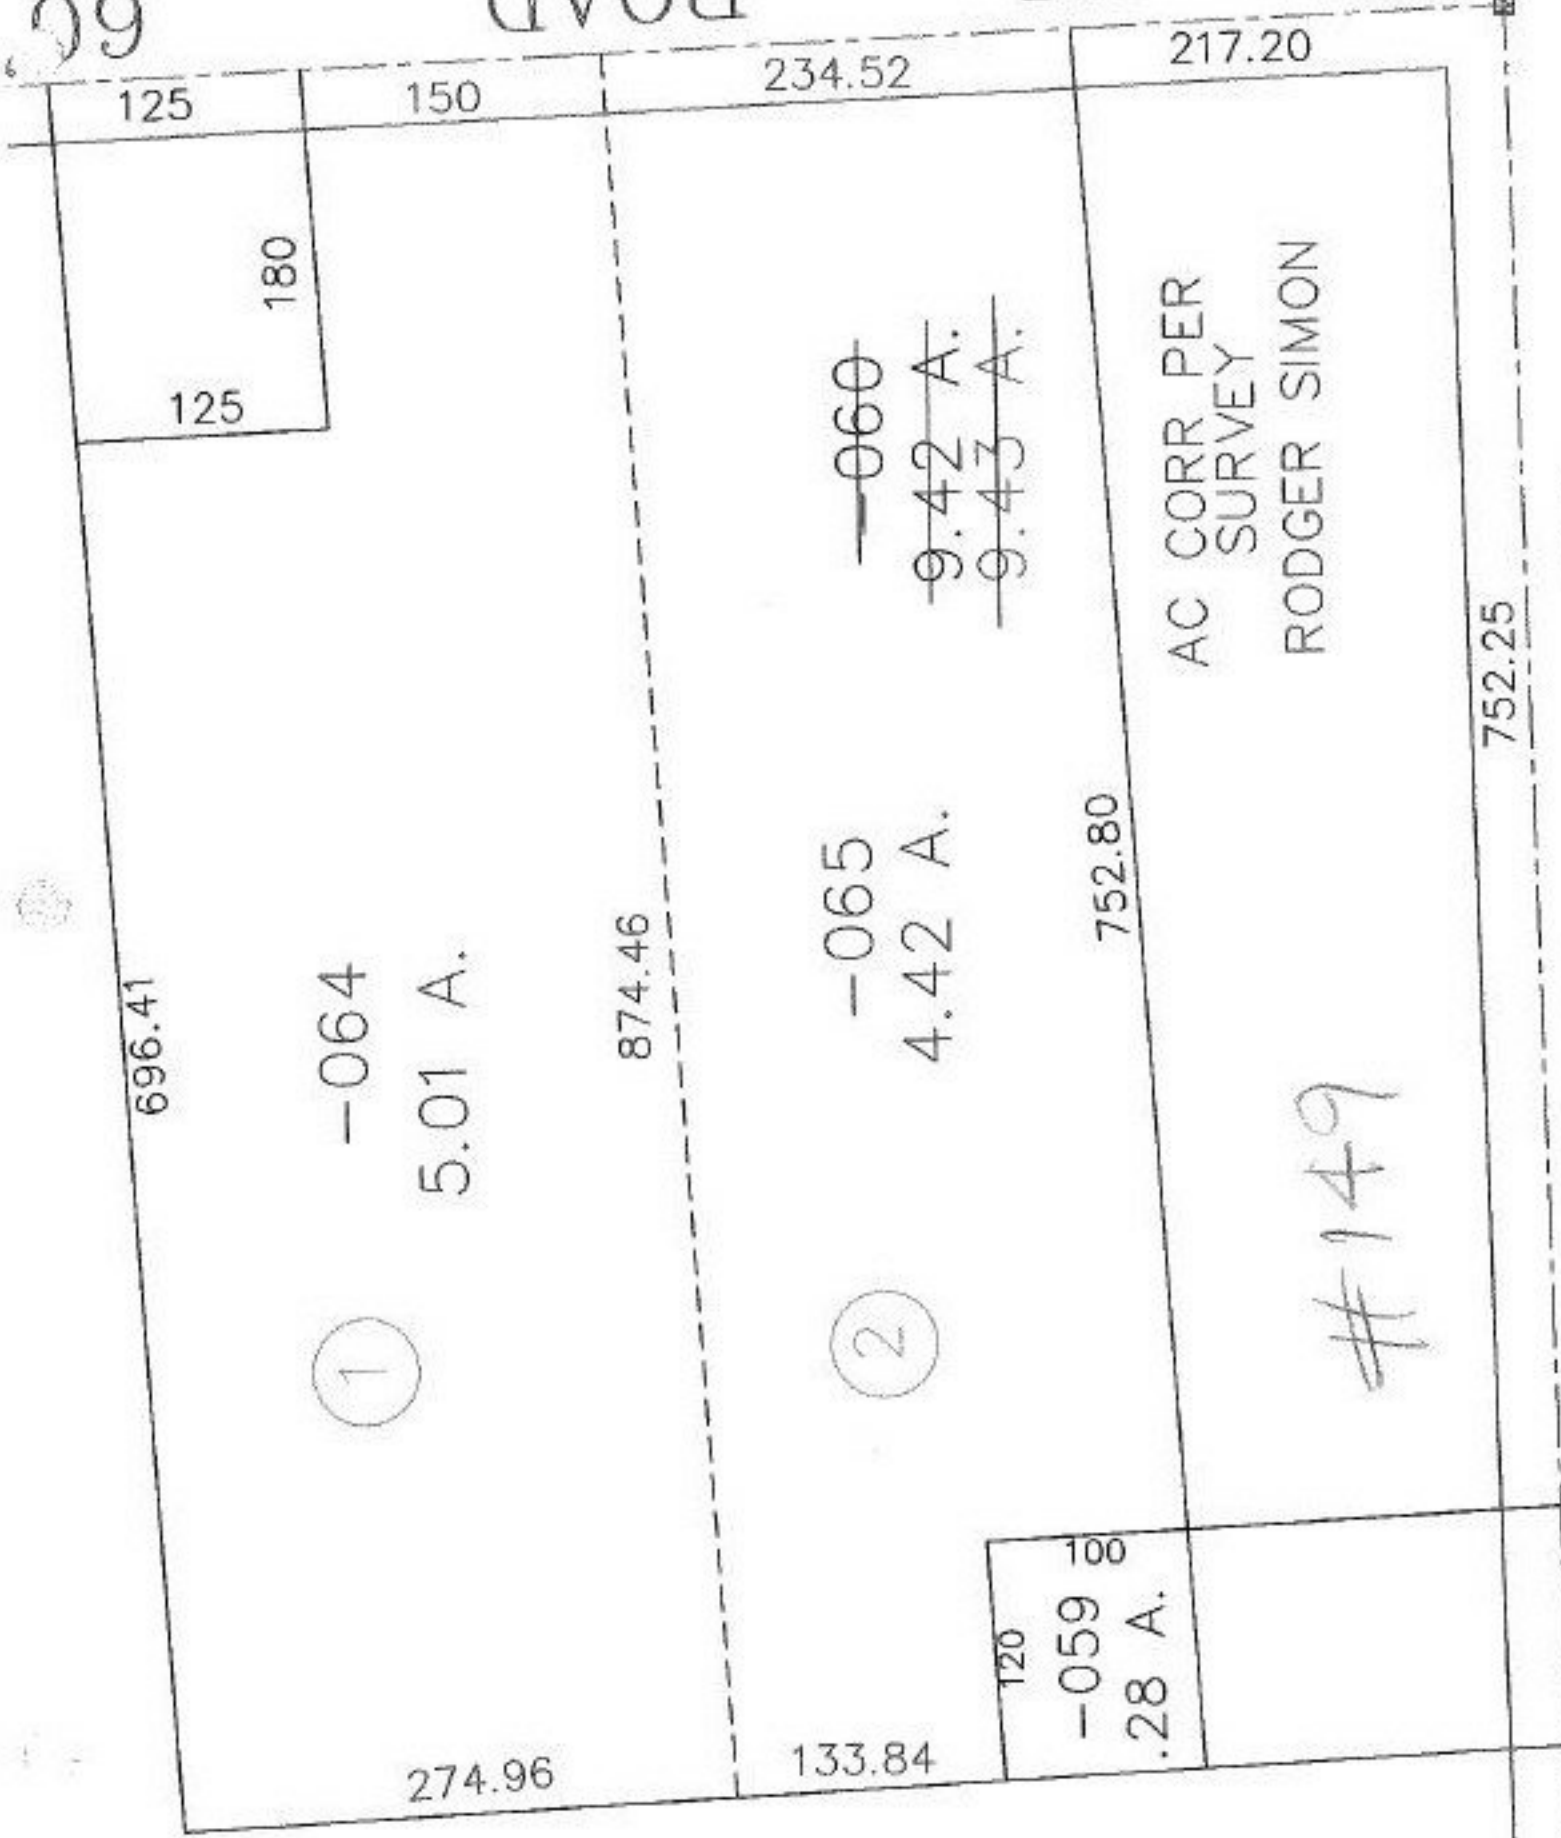

CADDT ROAD 60

AC CORR PER SURVEY RODGER SIMON

#149

120
-059 100
.28 A.

~~-060~~
~~9.42 A.~~
~~9.43 A.~~