

PARENT PARCEL: 06-24-035-101-003

CHILD PARCEL: 06-24-035-101-057 THRU -059

STARTING POINT: N.W. CORNER OF S\ 35

NO. 00149-U

UNCOMBINATION

~~06-24-035-101-002~~
~~80 X 127~~

06-24-035-101-057
60 X 126.74


06-24-035-101-058
10 X 126.72

06-24-035-101-059
10 X 126.72

PER DEED
OR 866/773



— EDISON — CT. —

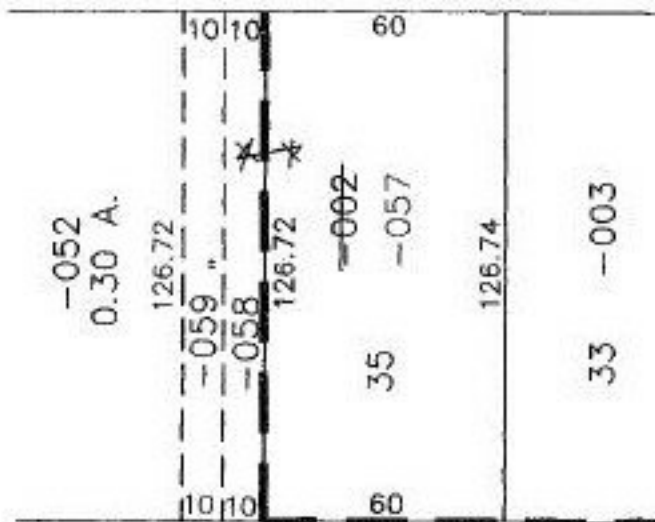

SPLITS/DEEDS PROCESSED

LORAIN COUNTY TAX MAP DEPARTMENT
226 MIDDLE AVE. ELYRIA, OHIO

SURVEYED BY: NONE

CLOSURE: 0.11 : 10.000

MAP PAGE(S): 6-60

APPROVED BY: I. SPILLMAN DATE: 07/20/99

SCALE: 1" = 50' PRIOR INSTRUMENT: DV 550/245