


PARENT PARCEL: 11-00-084-000-060

CHILD PARCEL: 11-00-084-000-064, -065

STARTING POINT: I.P.L MON BOX CL OF DURKEE AT INT OF CL CAPEL

NO. 00149

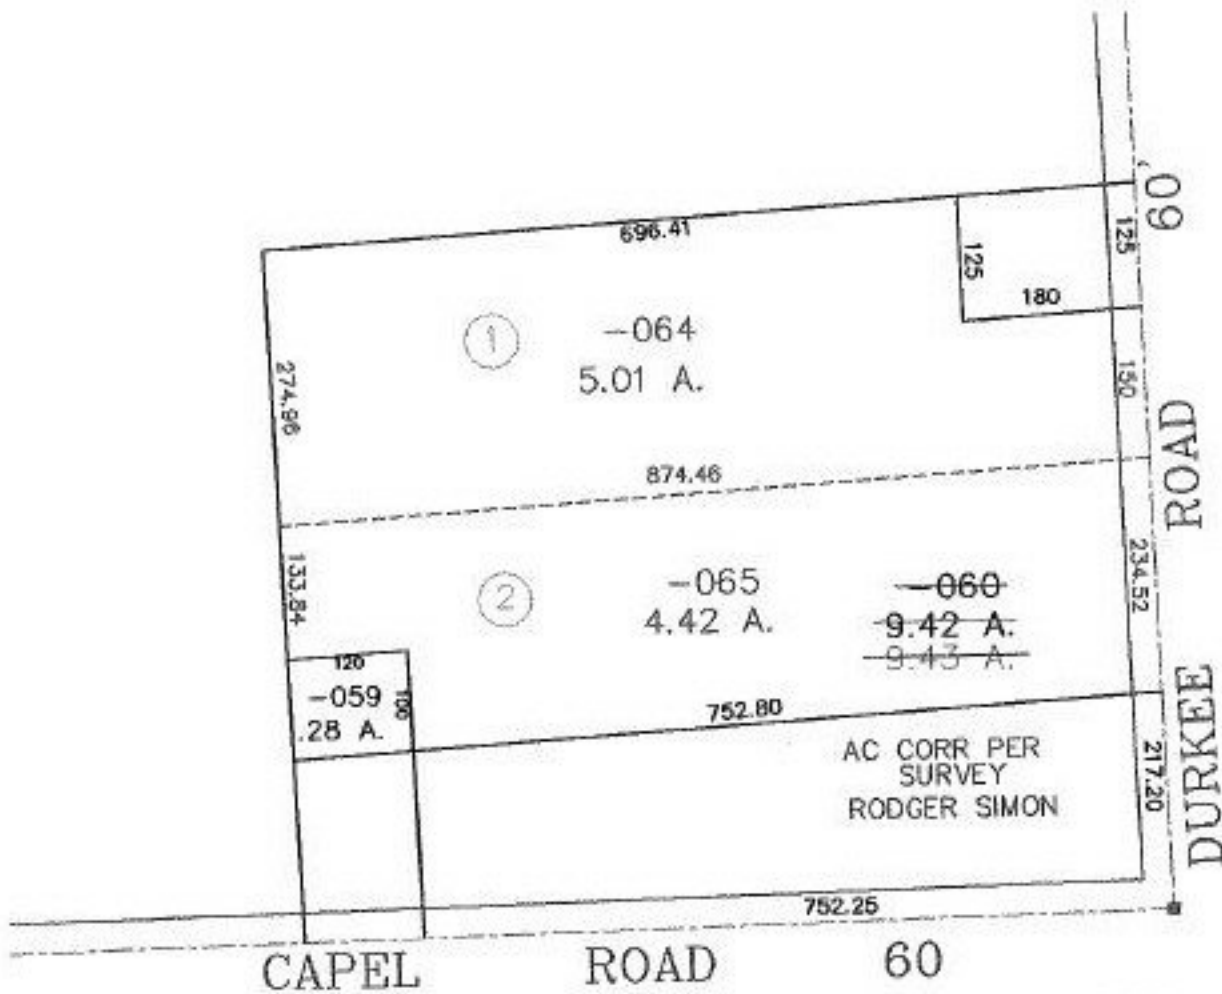

T3
2-17-00



SPLITS/DEEDS PROCESSED
LORAIN COUNTY TAX MAP DEPARTMENT
226 MIDDLE AVE. ELYRIA, OHIO

SURVEYED BY:	RODGER G. SIMON
CLOSURE:	0.02 : 10.000
MAP PAGE(S):	11-00-084
APPROVED BY:	DRH
DATE:	7/14/99
SCALE:	1" = 200
PRIOR INSTRUMENT:	970476057