


PARENT PARCEL: 03-00-061-106-013

CHILD PARCEL: 03-00-061-106-048, 049

STARTING POINT: INT. C.L. COLORADO AVE AND WESTERLY LINE OF O.L. 61

NO. 00150

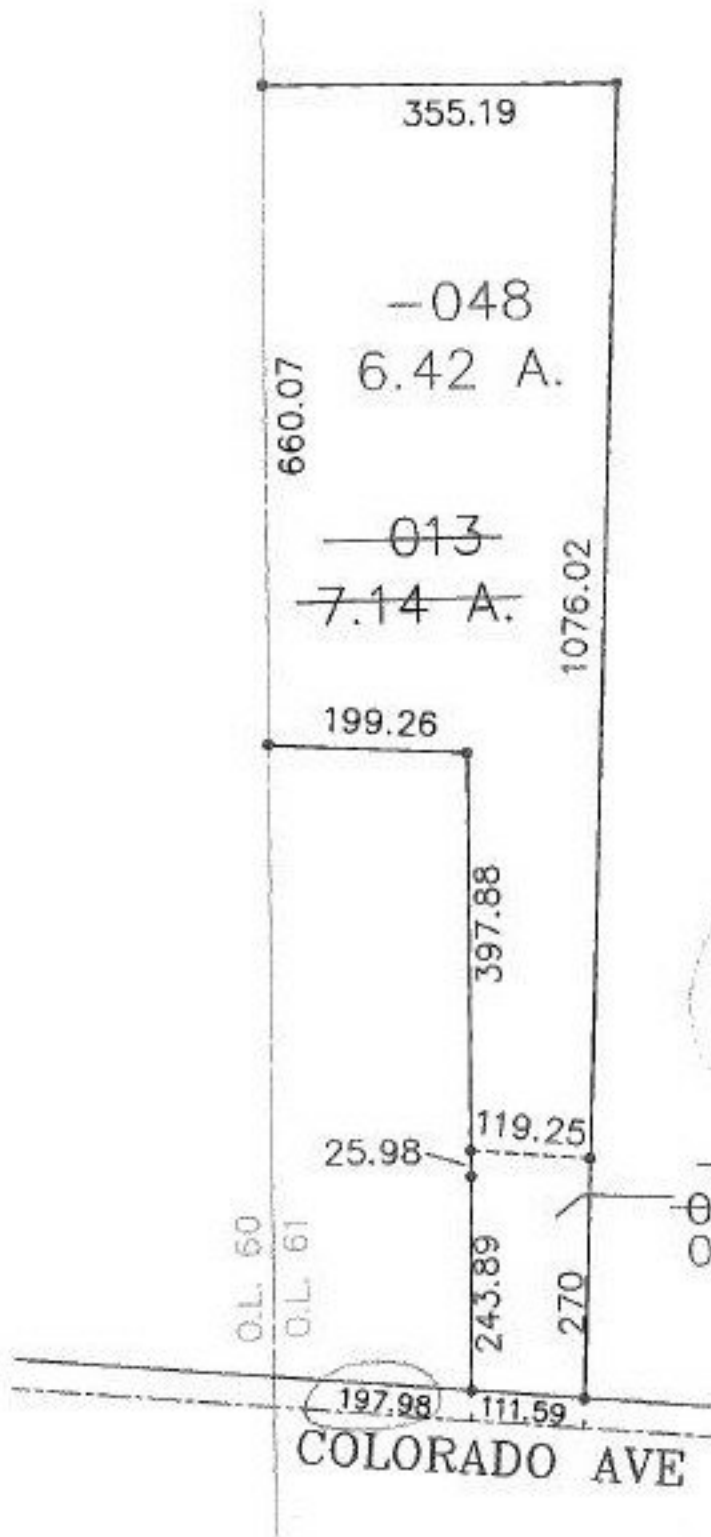

*Put Both
Dims on Map*

AC. CORR. PER
PER SURVEY
DOUGLAS H. MOSLEY

9-20-99



SPLITS/DEEDS PROCESSED
LORAIN COUNTY TAX MAP DEPARTMENT
226 MIDDLE AVE. ELYRIA, OHIO

SURVEYED BY: DOUGLAS H. MOSLEY
CLOSURE: 0.07 : 10,000
MAP PAGE(S): 3-00-061-B
APPROVED BY: DRH DATE: 7/15/99
SCALE: 1" = 200' PRIOR INSTRUMENT: OR 132/274