

PARENT PARCEL: 04-00-011-108-055 THRU -058
CHILD PARCEL: 04-00-011-110-001 THRU -004
STARTING POINT: XXXXXX


NO. 00152-X

PARCEL NUMBER CORRECTION



- ~~04-00-011-108-055~~
- 04-00-011-110-001
- ~~04-00-011-108-056~~
- 04-00-011-110-002
- ~~04-00-011-108-057~~
- 04-00-011-110-003
- ~~04-00-011-108-058~~
- 04-00-011-110-004

SEE PLAT 99-00174

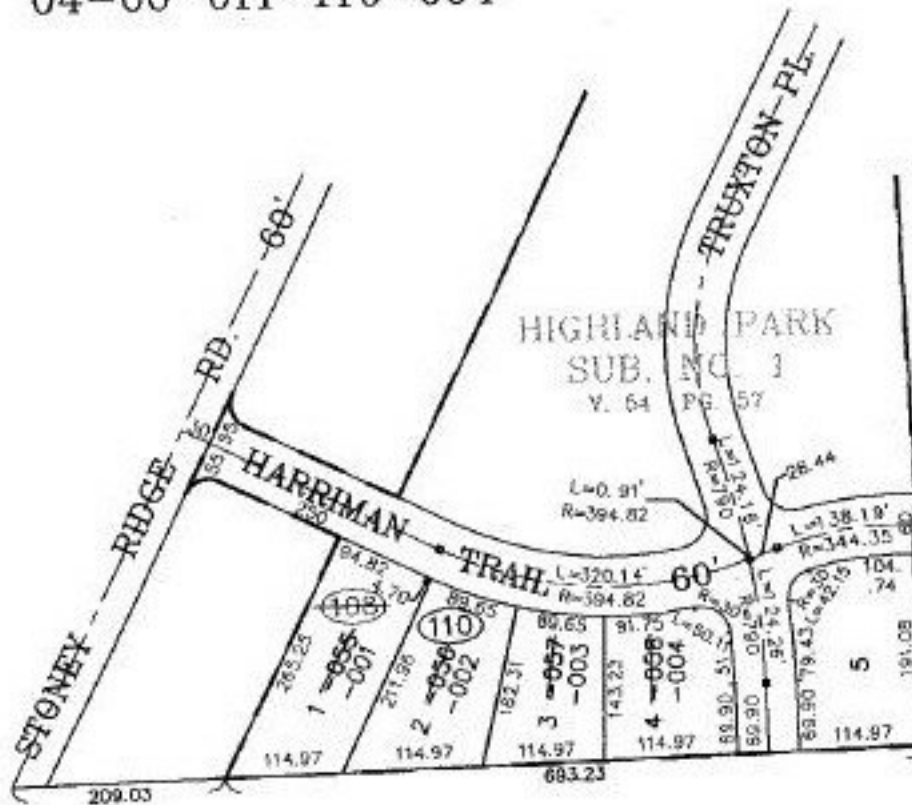

SPLITS/DEEDS PROCESSED
LORAIN COUNTY TAX MAP DEPARTMENT
226 MIDDLE AVE. ELYRIA, OHIO

SURVEYED BY: RICHARD A. ROSEBECK
CLOSURE: NA
MAP PAGE(S): 04-00-011-H
APPROVED BY: T. SPILLMAN DATE: 08/20/99
SCALE: 1" = 200' PRIOR INSTRUMENT: NA