

PARENT PARCEL: 09-00-045-000-009
CHILD PARCEL: XX-XX-XXX-XXX-XXX
STARTING POINT: N.E. CORNER OF O.L. 45

NO. 00158-D

ACREAGE CORRECTION

09-00-045-000-009


~~53.00~~ A.

53.64 A.

AC. CORR. PER DEED
DV 1010/216

SURVEY & UPDATE LEGAL
BEFORE NEXT TRANSFER

ADD "INTEND TO CONVEY"
STATEMENT AFTER BOTH
EXCEPTIONS.

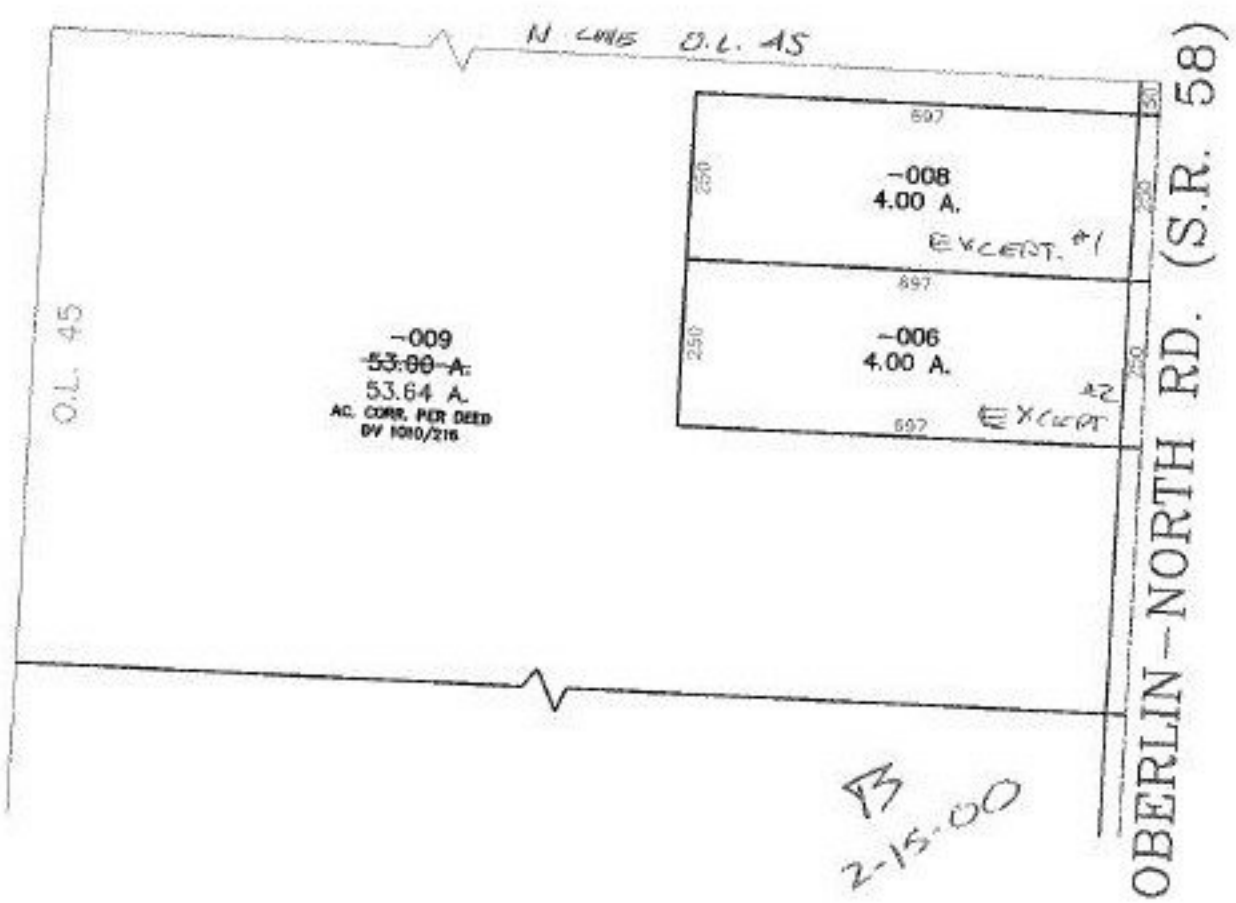

SPLITS/DEEDS PROCESSED
LORAIN COUNTY TAX MAP DEPARTMENT
226 MIDDLE AVE. ELYRIA, OHIO

SURVEYED BY: NONE
CLOSURE: CAN'T RUN
MAP PAGE(S): 9-B
APPROVED BY: I. SPILLMAN DATE: 08/19/99
SCALE: 1" = 300' PRIOR INSTRUMENT: DV 1010/216