

PARENT PARCEL: 10-00-005-101-498

CHILD PARCEL: XXXXXXXXXXXX

STARTING POINT: S\ L 190, UNIVERSITY OAKS SUB. NO. 7


NO. 00160-X

FRONTAGE CORRECTION

10-00-005-101-498

~~89.15 X 135.12~~

69.19 X 135.12

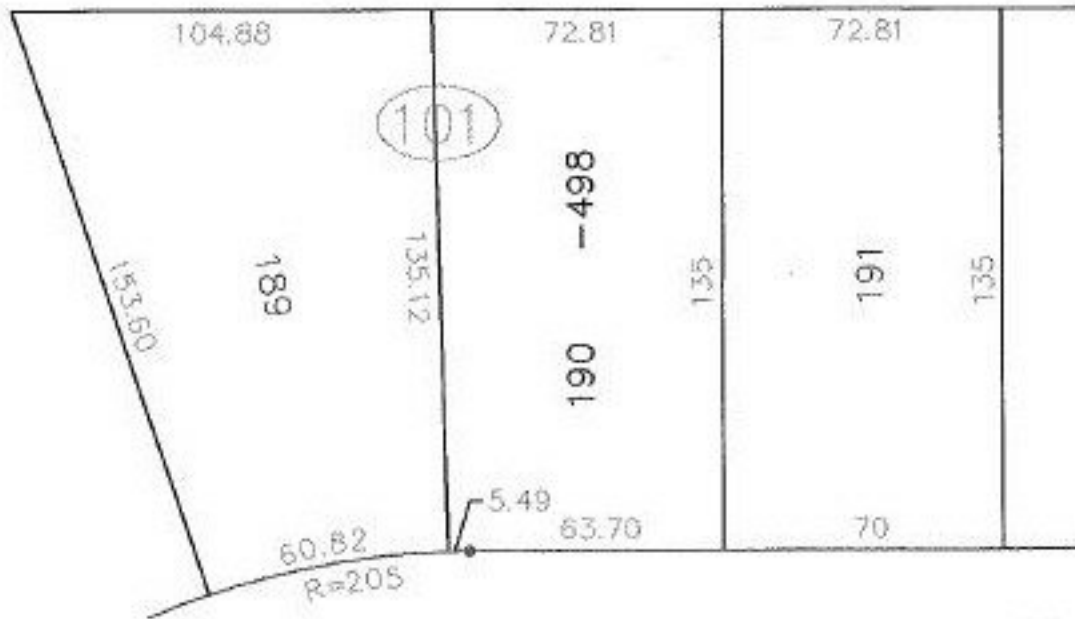

~~FERRIS STATE CT. - 60'~~



SPLITS/DEEDS PROCESSED
LORAIN COUNTY TAX MAP DEPARTMENT
 226 MIDDLE AVE. ELYRIA, OHIO

SURVEYED BY: KS & ASSOC.
 CLOSURE: 0.00 : 10.000
 MAP PAGE(S): 10-00-005-A
 APPROVED BY: IJS DATE: 06/21/99
 SCALE: 1" = 50' PRIOR INSTRUMENT: NONE