

PARENT PARCEL: 19-05-013-000-004


CHILD PARCEL: 19-05-013-000-005 THRU -008

STARTING POINT: MON. BOX, CL OF PECK-WADSWORTH RD. & CL OF WHITEHEAD RD.

NO. 00161



PECK-WADSWORTH RD. 60'

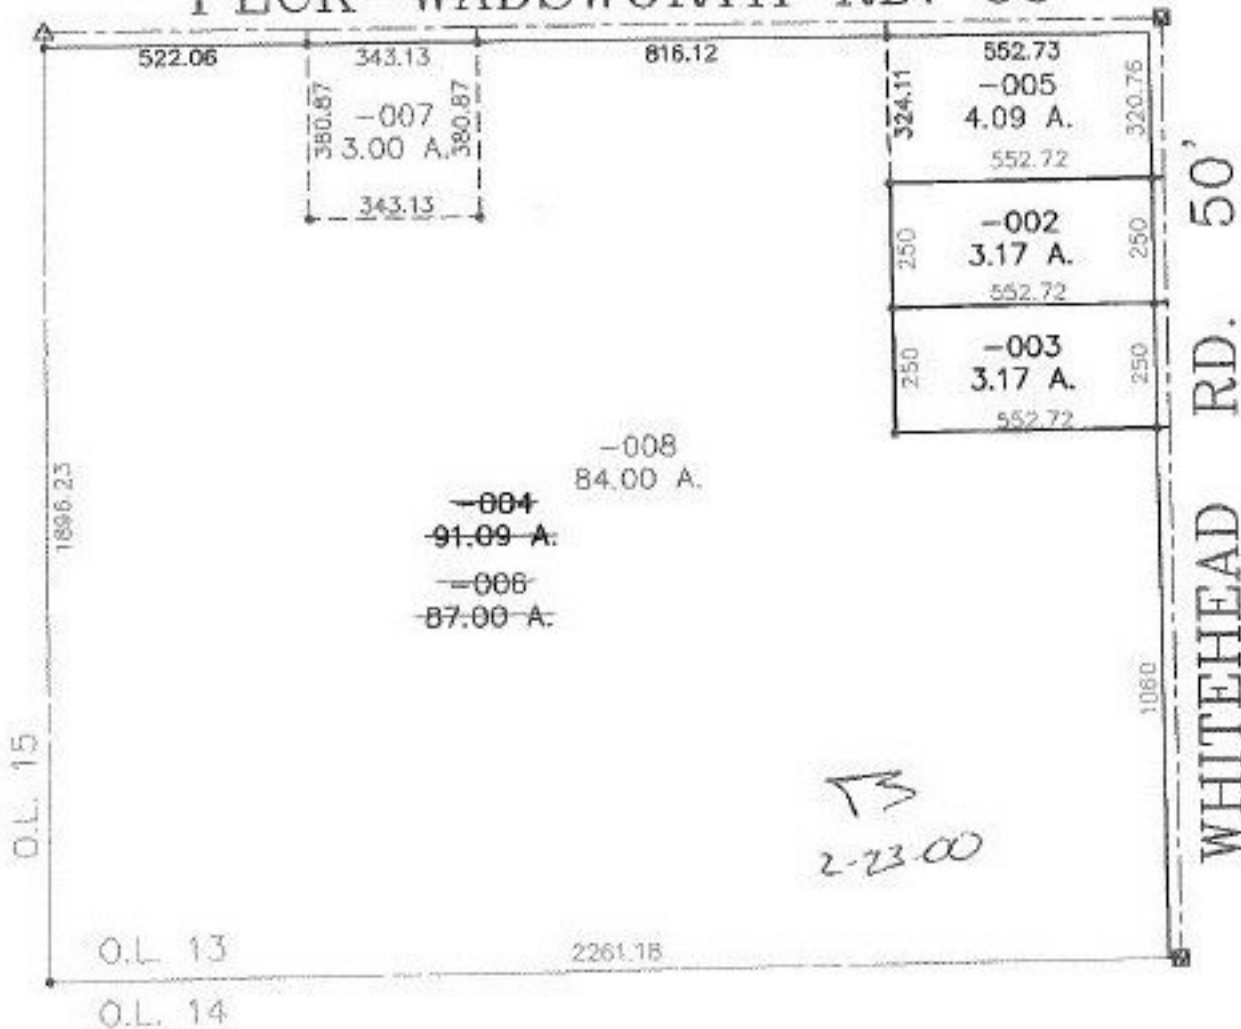

**SPLITS/DEEDS PROCESSED**  
LORAIN COUNTY TAX MAP DEPARTMENT  
226 MIDDLE AVE. ELYRIA, OHIO

SURVEYED BY: RONALD L. LAUGHERY

CLOSURE: 0.02 : 10,000

MAP PAGE(S): 19-A

APPROVED BY: TJS DATE: 07/15/99

SCALE: 1" = 400' PRIOR INSTRUMENT: OR 1075/61