


PARENT PARCEL: 15-00-100-000-020

CHILD PARCEL: XX-XX-XXX-XXX-XXX

STARTING POINT: CL OF NICKLE PLATE DIAGONAL RD. & CL OF WEBSTER RD.

NO. 00162-A

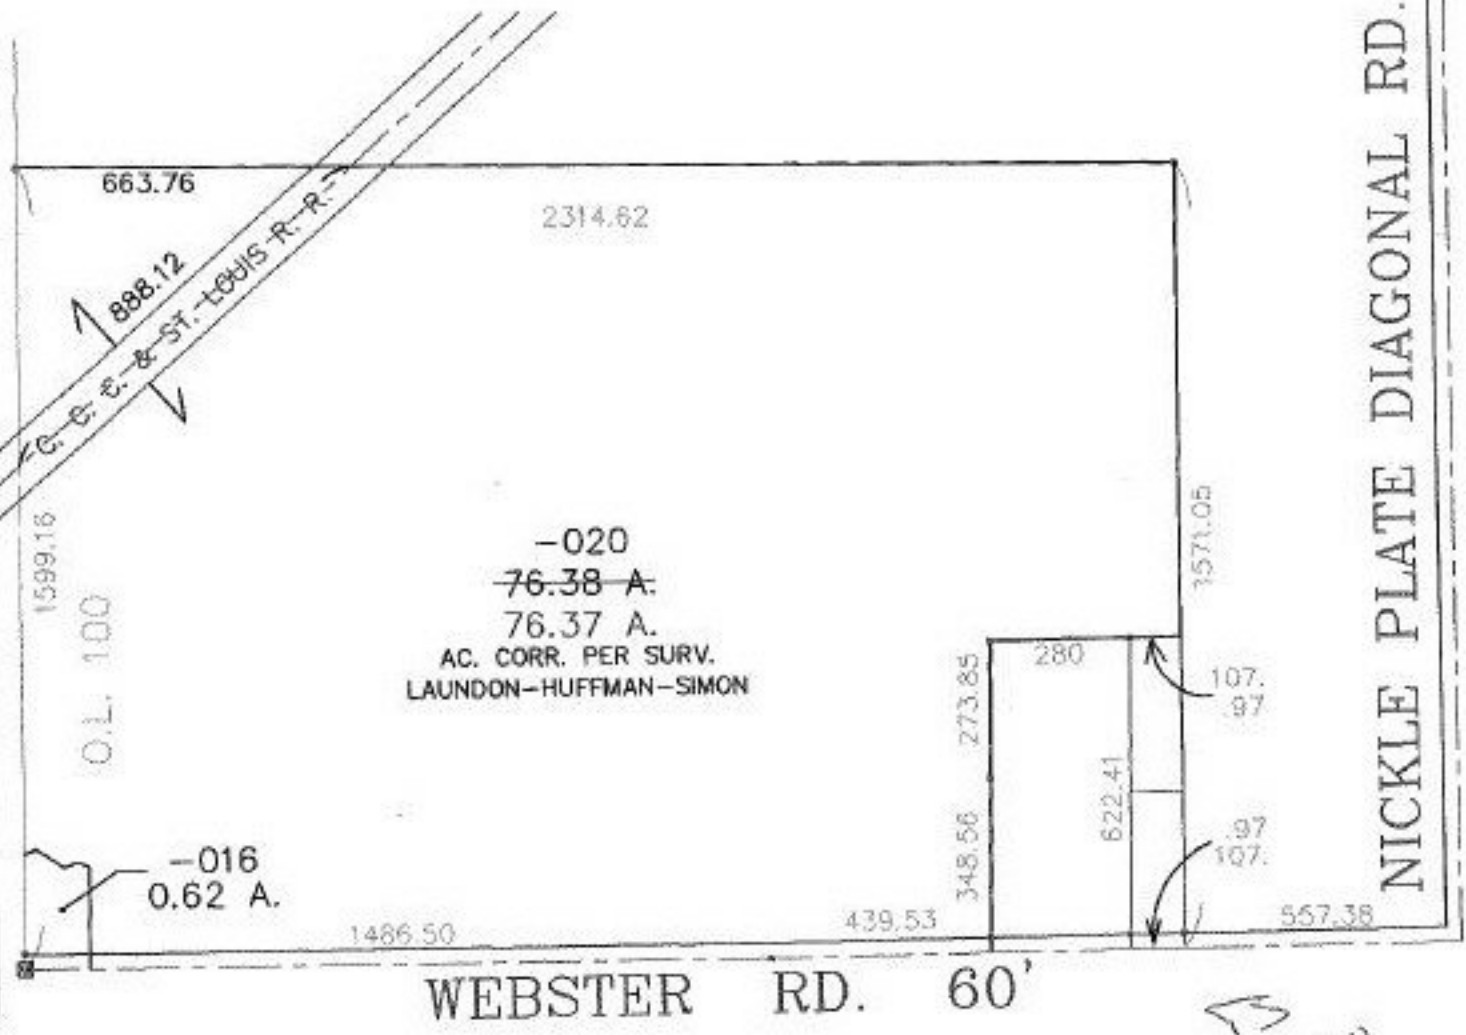

2-21-00



SPLITS/DEEDS PROCESSED
 LORAIN COUNTY TAX MAP DEPARTMENT
 226 MIDDLE AVE. ELYRIA, OHIO

SURVEYED BY: LAUNDON-HUFFMAN-SIMON
 CLOSURE: 0.02 : 10,000
 MAP PAGE(S): 15-E
 APPROVED BY: TJS DATE: 06/22/99
 SCALE: 1" = 400' PRIOR INSTRUMENT: DV 891/260