



PARENT PARCEL: 01-00-074-000-023

CHILD PARCEL: 01-00-074-000-024, -025

STARTING POINT: MON BOX INT OF BAUMHART RD AND SL OF O.L. 74

NO. 00163

Will ACCEPT S. LINE
SOUTH LINE

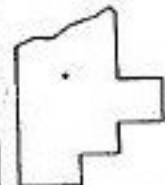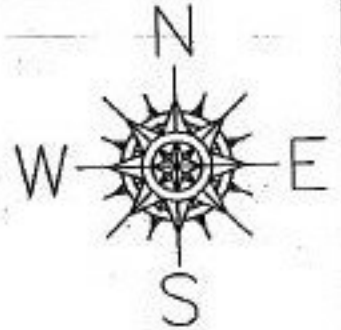

SPLITS/DEEDS PROCESSED
 LORAIN COUNTY TAX MAP DEPARTMENT
 226 MIDDLE AVE. ELYRIA, OHIO

SURVEYED BY: CHARLES P. WARYU
 CLOSURE: 0.00 : 10.000
 MAP PAGE(S): 01-00-074-B
 APPROVED BY: DRH DATE: 7/19/99
 SCALE: 1" = 200' PRIOR INSTRUMENT: OR 394/334