

PARENT PARCEL: VACATION OF MENCEL RD.

CHILD PARCEL: XX-XX-XXX-XXX-XXX

STARTING POINT: XXXXXX

NO. 00165-V


# STREET VACATION

MENCEL RD.  
EATON TWP.  
RES. NO. 99-421



# MAP CORRECTION

~~MENCEL RD.~~  
MENCEL RD.

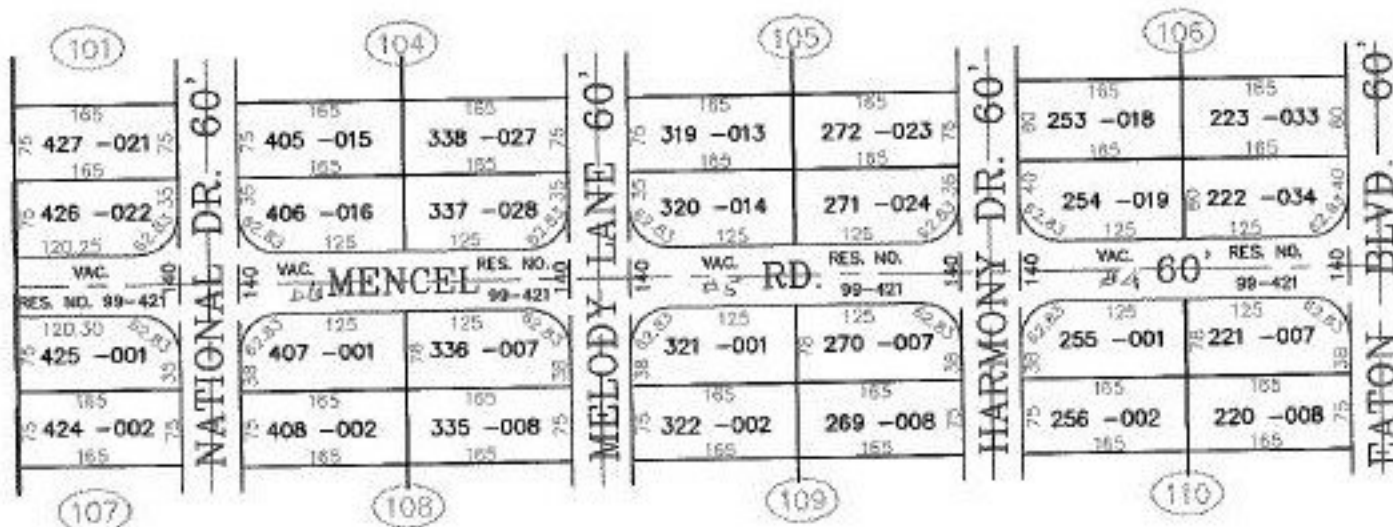

1 OF 2



**SPLITS/DEEDS PROCESSED**  
LORAIN COUNTY TAX MAP DEPARTMENT  
226 MIDDLE AVE. ELYRIA, OHIO

SURVEYED BY: NONE  
CLOSURE: CAN'T RUN  
MAP PAGE(S): 11-00-036-BA  
APPROVED BY: I. SPILLMAN DATE: 08/17/99  
SCALE: 1" = 200' PRIOR INSTRUMENT: NONE