


PARENT PARCEL: 20-05-010-000-002 THRU -004, 20-05-009-000-003,  
 PARENT PARCEL: 20-05-011-000-001, 20-05-017-103-004 THRU -007  
 CHILD PARCEL: 20-05-010-000-005 THRU -008, 20-05-004-000-013, & -014  
 CHILD PARCEL: 20-05-017-103-028 & -029  
 STARTING POINT: I.P., CL OF QUARRY RD. & CL OF GRIGGS

NO. 00165

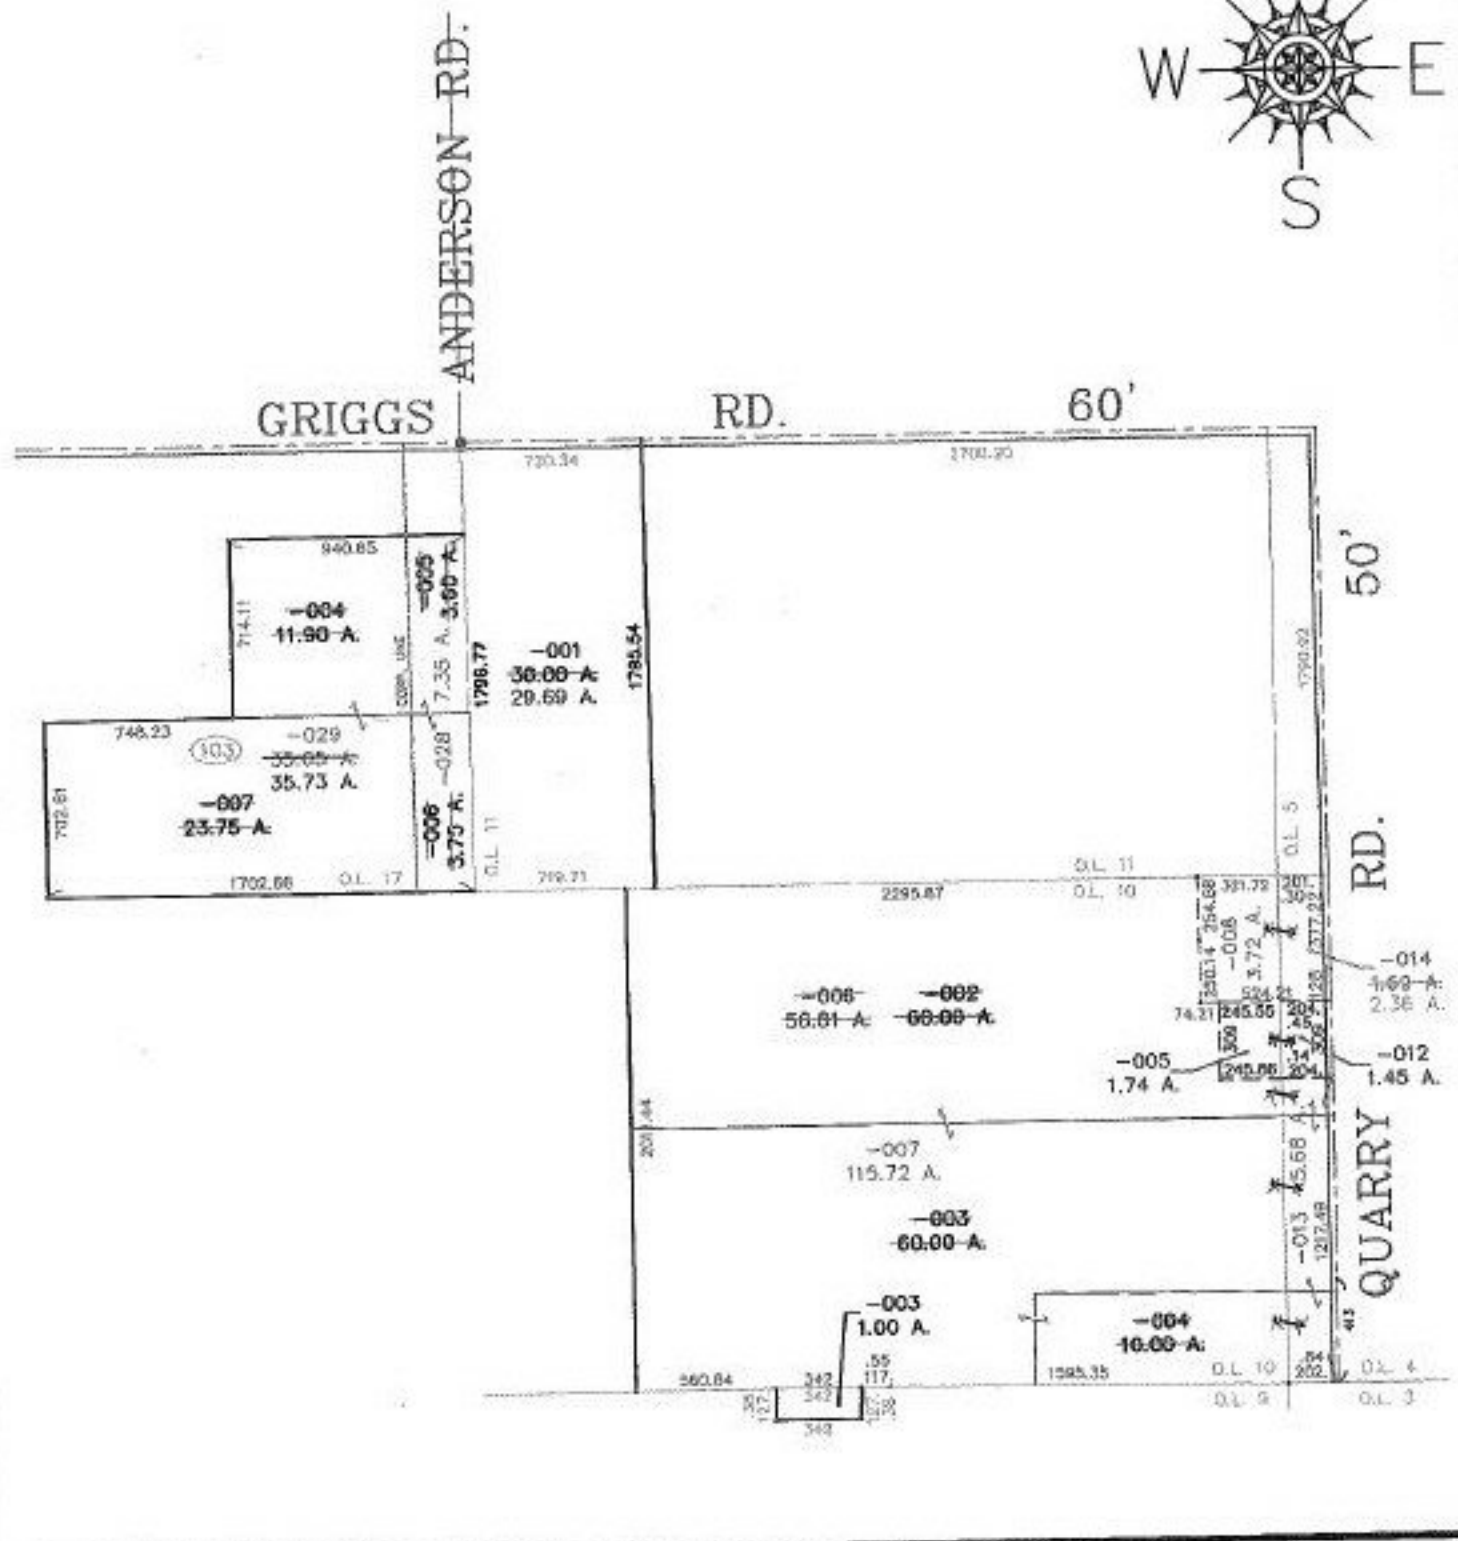

**SPLITS/DEEDS PROCESSED**  
 LORAIN COUNTY TAX MAP DEPARTMENT  
 226 MIDDLE AVE. ELYRIA, OHIO

SURVEYED BY: DANE A. HAPONEK  
 CLOSURE: 0.79 : 10.000  
 MAP PAGE(S): 20-C & D. & 20-05-017-B  
 APPROVED BY: TJS DATE: 07/16/99  
 SCALE: 1" = 800' PRIOR INSTRUMENT: 980557849

STW  
 2/24/00