

PARENT PARCEL: 04-00-013-000-007

CHILD PARCEL: 04-00-013-000-284, -285

STARTING POINT: CL AVON BELDON @ POINT DIST SOUTH 14 FT FROM SE CORNER OF
PARCEL CONVEYED TO LEONA A. BERCHAK

NO. 00167



--- RIEGELSBERGER ROAD ---

362.92


RD 60'

476.92

BELDON

AVON

AC. CORR
PER
SURVEY
JAMES A. RESAR

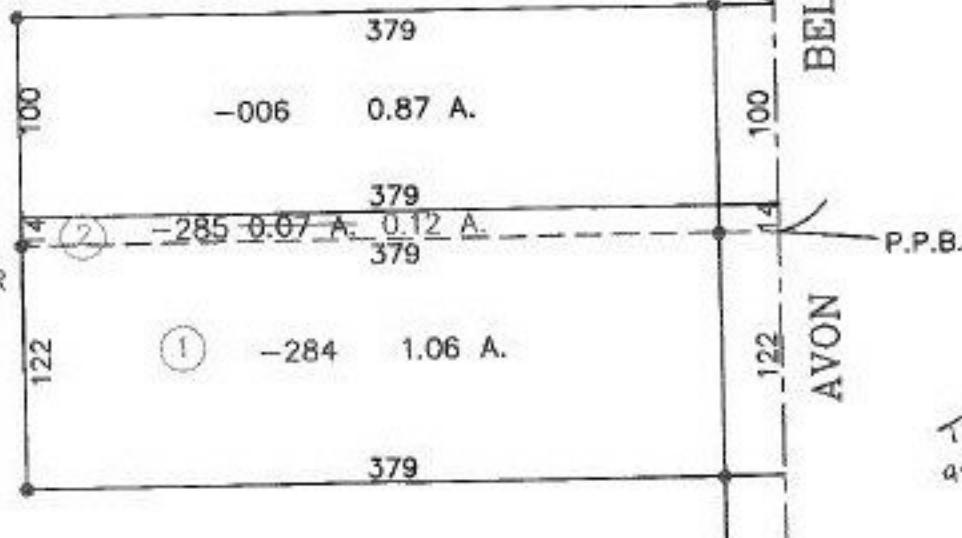

TS
9-20-99



SPLITS/DEEDS PROCESSED

LORAIN COUNTY TAX MAP DEPARTMENT
226 MIDDLE AVE. ELYRIA, OHIO

SURVEYED BY:	JAMES A. RESAR
CLOSURE:	0.00 : 10.000
MAP PAGE(S):	04-00-013-B
APPROVED BY:	DRH
DATE:	8/3/99
SCALE:	1" = 100'
PRIOR INSTRUMENT:	DV 725/59