

PARENT PARCEL: 09-00-086-106-003

CHILD PARCEL: XXXXXXXXXXXX


STARTING POINT: WEST LINE OF S/L 1 AT A POINT ON THE CL OF PLEASANT 171'  
SOUTH OF THE CL OF COLLEGE ST.

NO. 00168-D



COLLEGE ST. 60'

PLEASANT ST. 171'

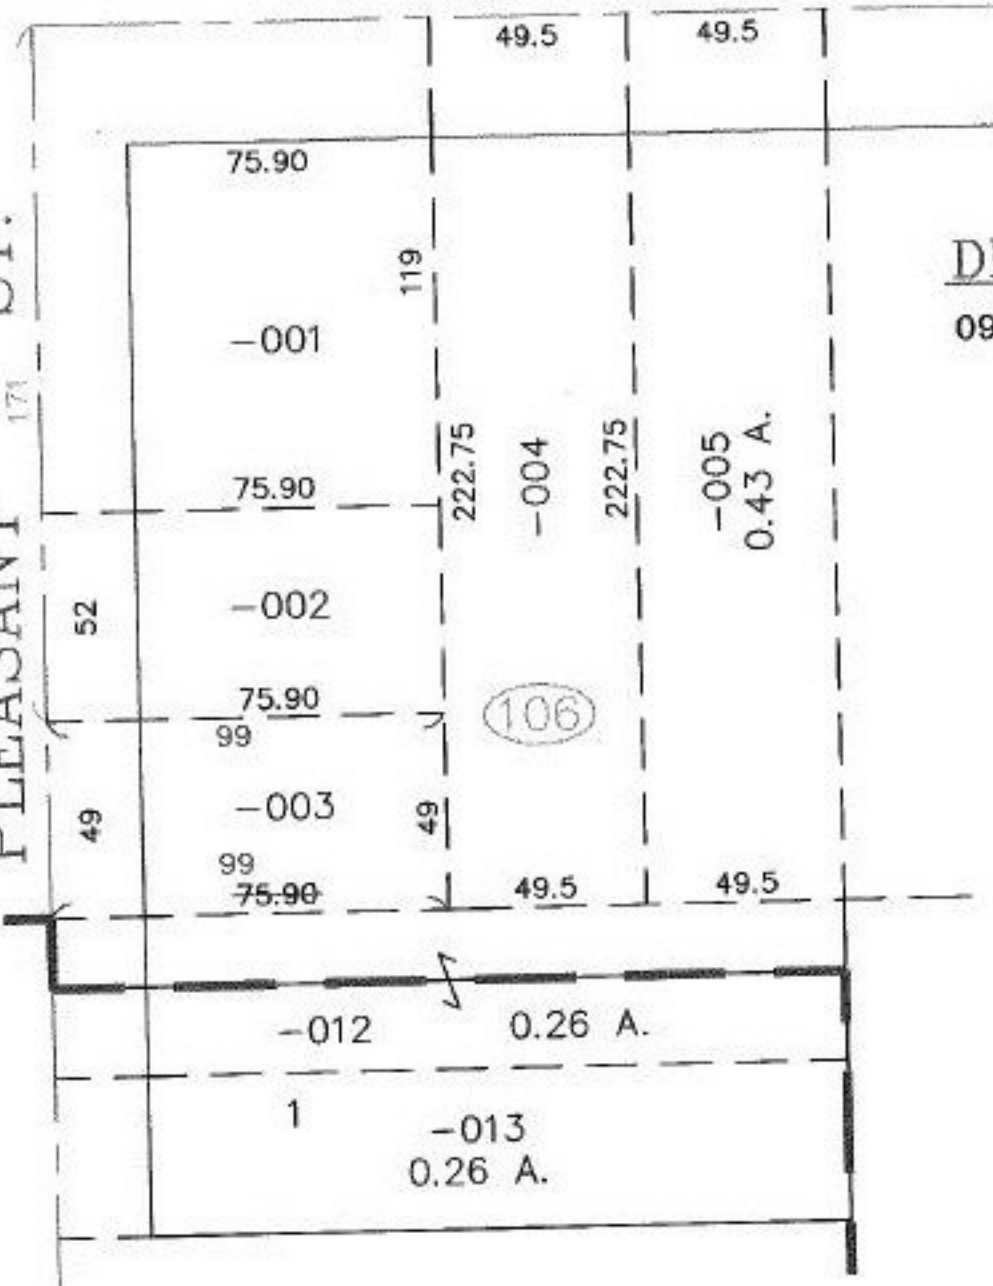

DEPTH CORR.

09-00-086-106-003

~~49 X 76~~

49 X 99

CORR. PER DEED  
OR 1078/409

T3  
2-14-00



SPLITS/DEEDS PROCESSED

LORAIN COUNTY TAX MAP DEPARTMENT  
226 MIDDLE AVE. ELYRIA, OHIO

SURVEYED BY: NONE

CLOSURE: CAN'T RUN

MAP PAGE(S): 09-00-086-A

APPROVED BY: TJS DATE: 07/09/99

SCALE: 1" = 50' PRIOR INSTRUMENT: OR 1078/409