


PARENT PARCEL: 16-00-077-000-009

CHILD PARCEL: 16-00-077-000-010, -011

STARTING POINT: INT. C.L. LAW ROAD & MENNELL ROAD

NO. 00168

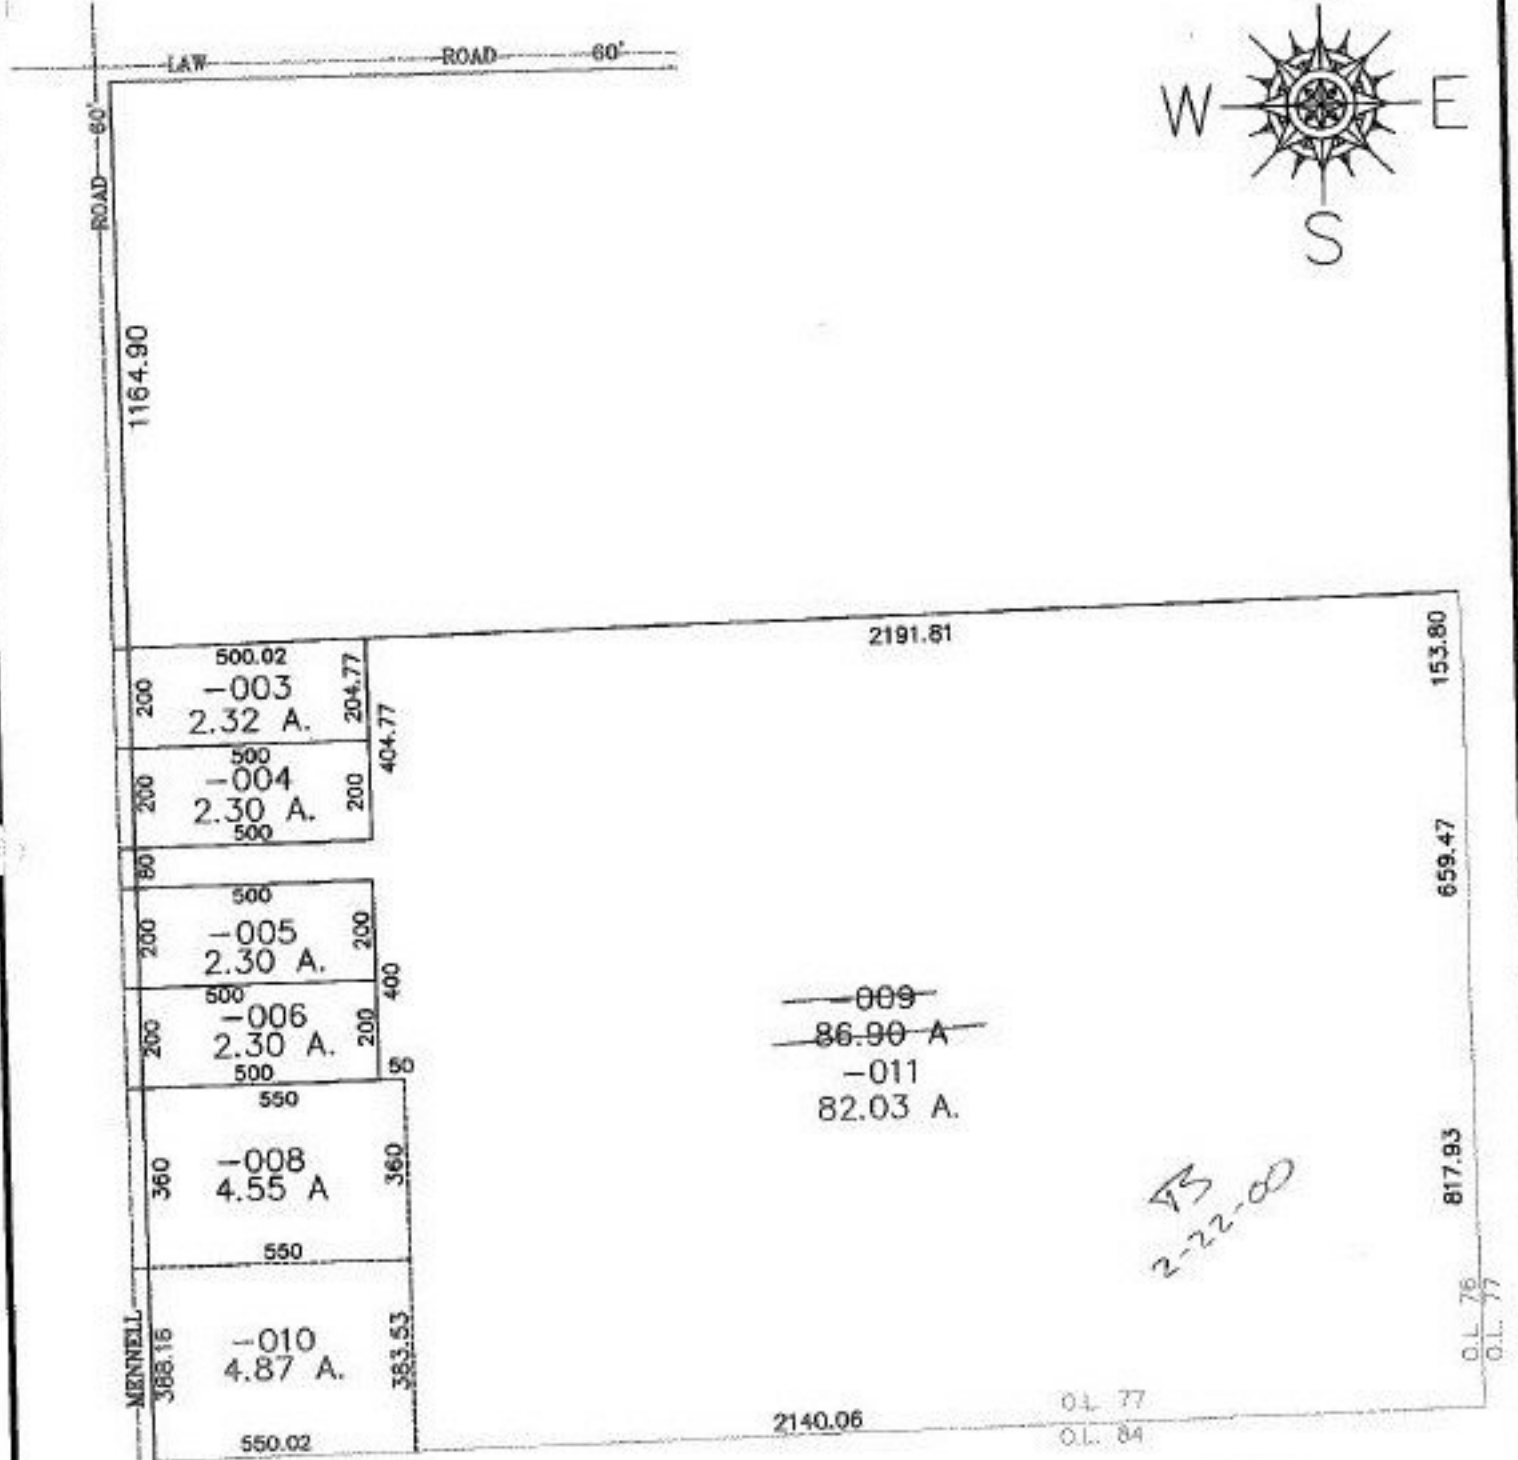

TS
2-22-00

#990621401

SURVEYED BY: CUNNINGHAM & ASSOC.
 CLOSURE: 0.00 : 10.000
 MAP PAGE(S): 16-F
 APPROVED BY: DRH DATE: 8/3/99
 SCALE: 1" = 400' PRIOR INSTRUMENT:

SPLITS/DEEDS PROCESSED
 LORAIN COUNTY TAX MAP DEPARTMENT
 226 MIDDLE AVE. ELYRIA, OHIO

