

PARENT PARCEL: 18-00-028-109-009

CHILD PARCEL: 18-00-028-109-025 & -026

STARTING POINT: MON. BOX, CL OF JOHNS ST. & CL OF WEST ST.

NO. 00169-A

DEPTH CORRECTION

DUP. & REGISTER

18-00-028-109-025

~~71 X 140.30~~

71 X 143.30


18-00-028-109-026

~~66 X 140.30~~

66 X 143.30



JOHNS ST. 66'

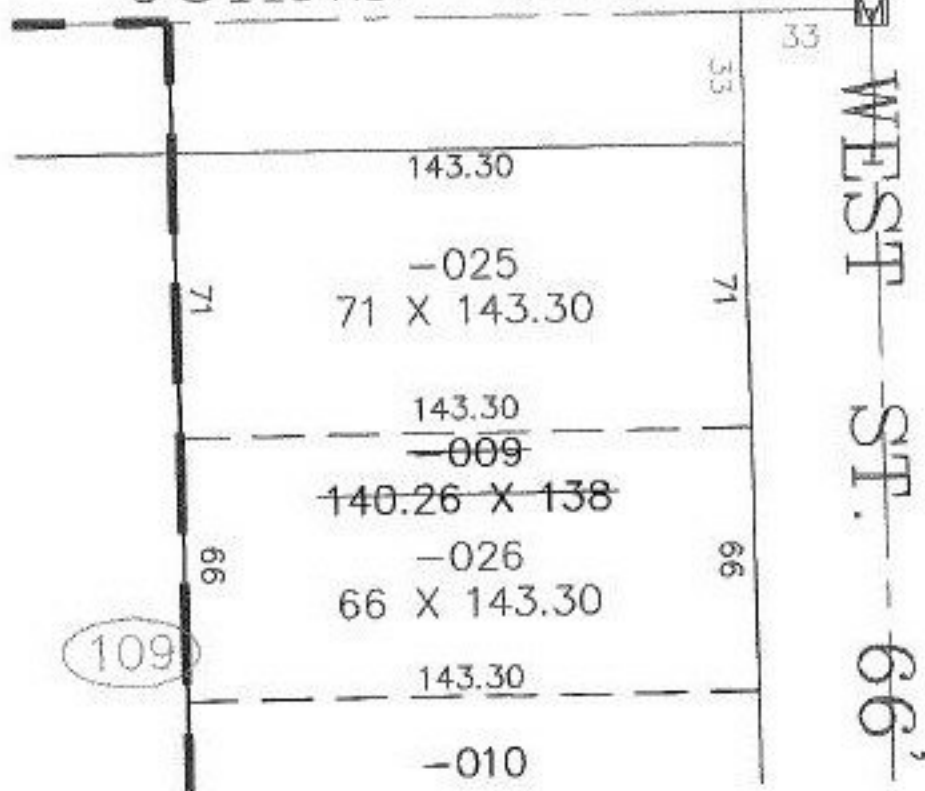

B
2-23-00



SPLITS/DEEDS PROCESSED
LORAIN COUNTY TAX MAP DEPARTMENT
226 MIDDLE AVE. ELYRIA, OHIO

SURVEYED BY: JOHN POZYWAK
CLOSURE: 0.00 : 10.000
MAP PAGE(S): 18-00-028-C
APPROVED BY: TJS DATE: 07/09/99
SCALE: 1" = 50' PRIOR INSTRUMENT: OR 1224/182