
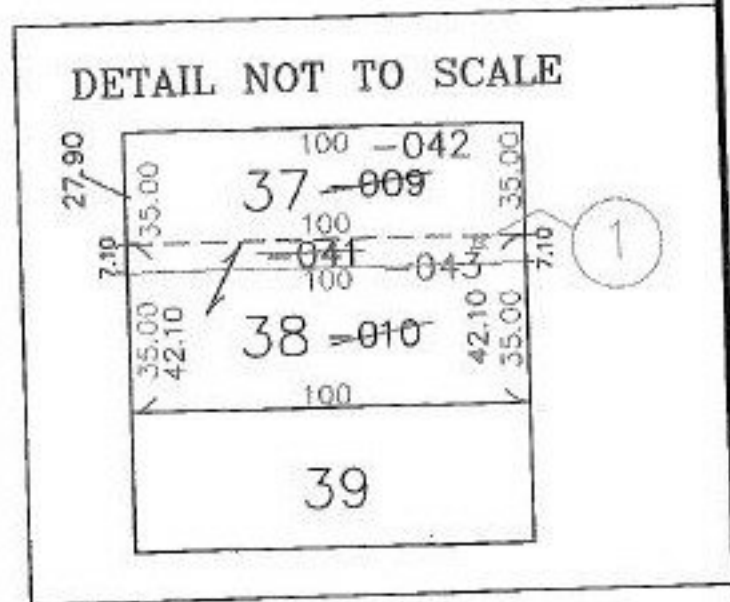


PARENT PARCEL: 03-00-038-108-009

CHILD PARCEL: 03-00-038-108-041, -042, -043

STARTING POINT: IP E LINE OF OAKWOOD AVE AND S LINE OF SL 38

NO. 00170

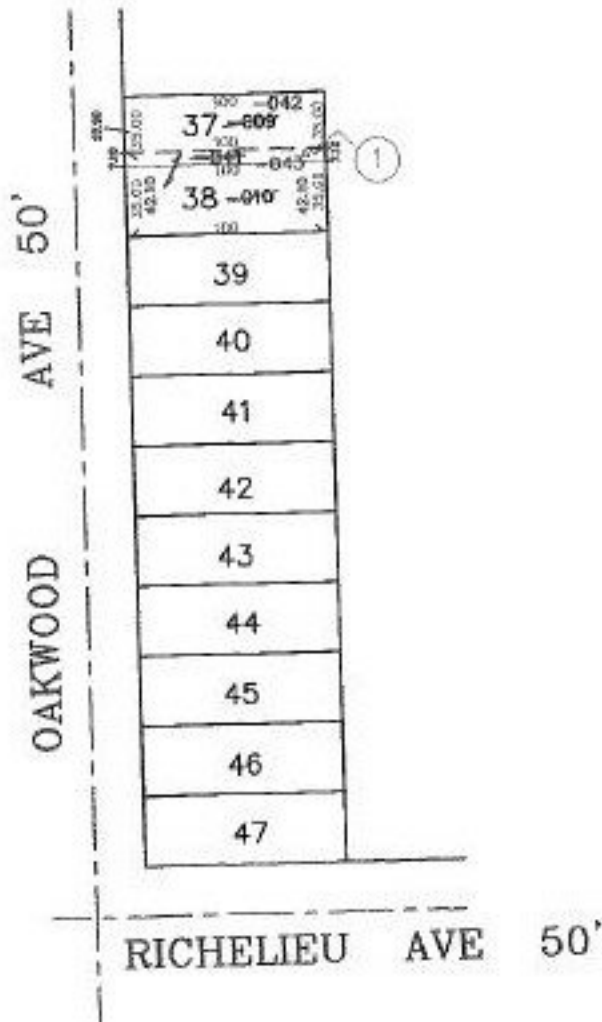

**SPLITS/DEEDS PROCESSED**

LORAIN COUNTY TAX MAP DEPARTMENT  
226 MIDDLE AVE. ELYRIA, OHIO

SURVEYED BY: PATRICK A. MCGANNON

CLOSURE: 0.00 : 10.000

MAP PAGE(S): 03-00-038-A

APPROVED BY: DRH DATE: 8/25/99

SCALE: 1" = 100' PRIOR INSTRUMENT: 990622302