

PARENT PARCEL: 01-00-006-102-036

CHILD PARCEL: 01-00-006-102-042 & -043

STARTING POINT: LP. IN THE SOUTHEAST END OF THE CL. OF NICHOLSON AVE.


NO. 00172



NICHOLSON AVE.

~~-036~~
34.45 A.

-043
26.45 A.

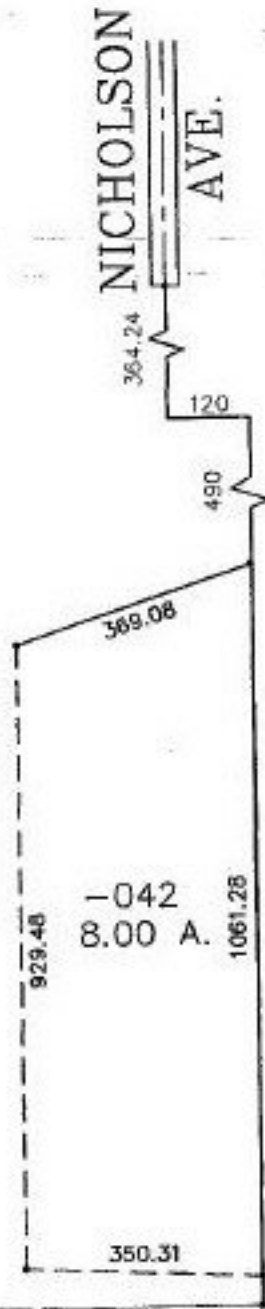

O.L. 6



SPLITS/DEEDS PROCESSED
LORAIN COUNTY TAX MAP DEPARTMENT
226 MIDDLE AVE. ELYRIA, OHIO

SURVEYED BY: M. G. HURA
CLOSURE: 0.02 : 10,000
MAP PAGE(S): 1-C
APPROVED BY: I. SPILLMAN DATE: 08/24/99
SCALE: 1" = 300' PRIOR INSTRUMENT: DV 1224/103