

PARENT PARCEL: 07-00-047-000-080


CHILD PARCEL: 07-00-047-000-108, -109

STARTING POINT: MON BOX INT OF CL TAYLOR PARKWAY AND O.L. LINE 47

NO. 00175



TAYLOR PARKWAY 70' S

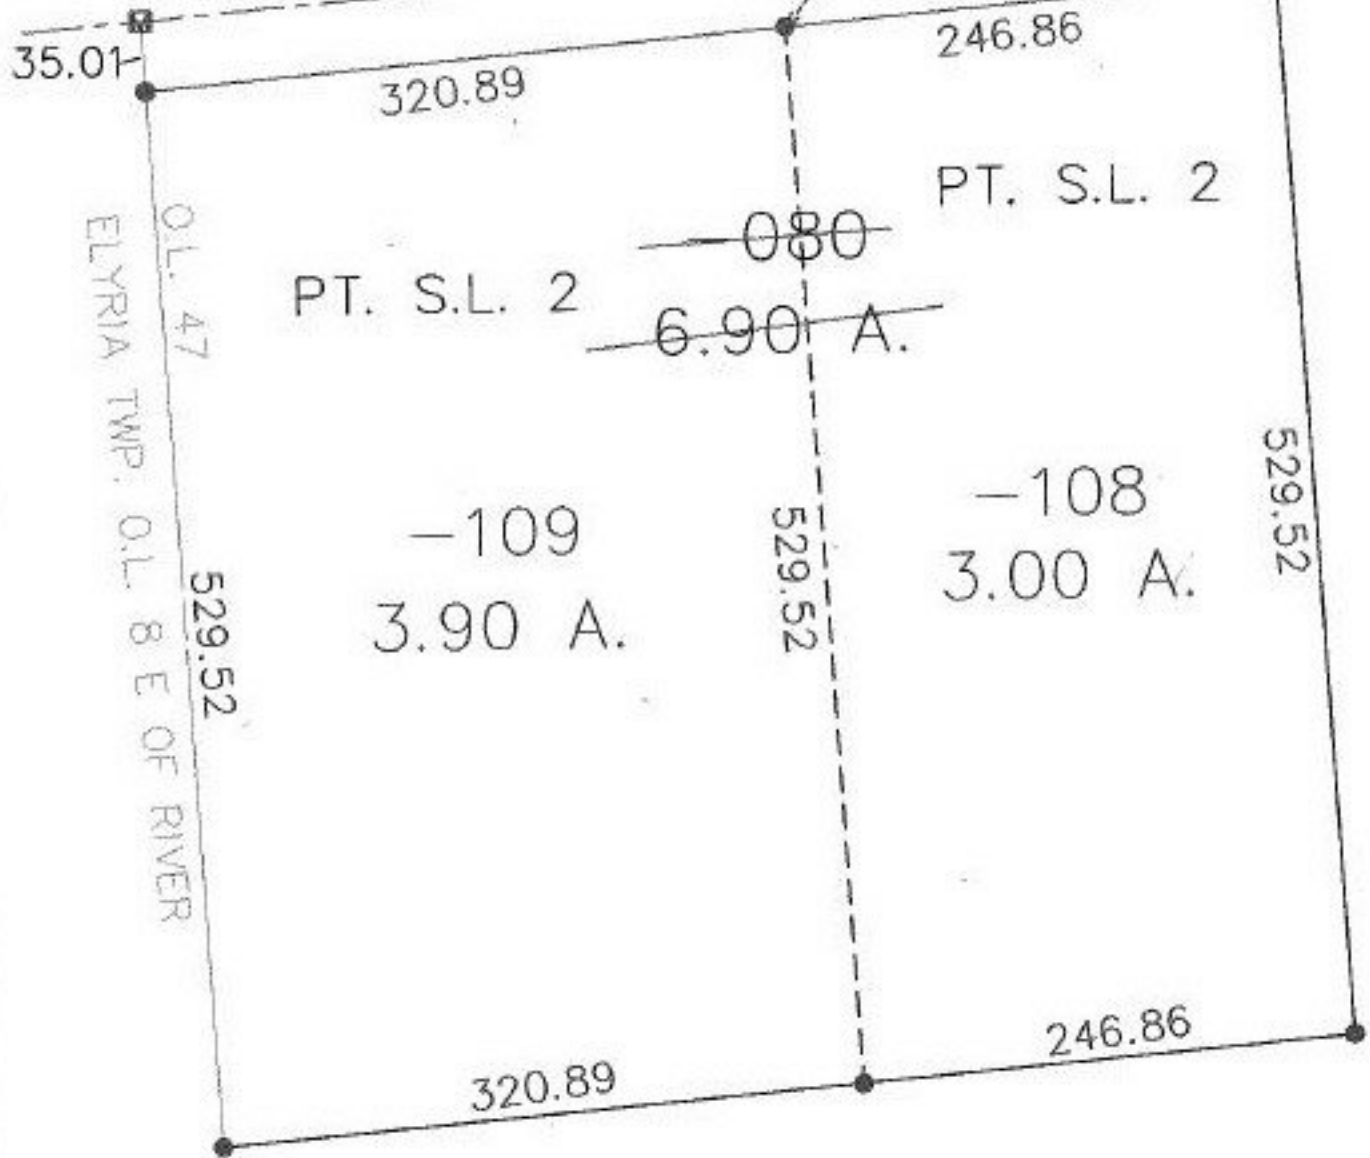

SPLITS/DEEDS PROCESSED

LORAIN COUNTY TAX MAP DEPARTMENT
226 MIDDLE AVE. ELYRIA, OHIO

SURVEYED BY: DAVID L. ELWELL

CLOSURE: 0.00 : 10.000

MAP PAGE(S): 07-00-047-A

APPROVED BY: DRH DATE: 8/6/99

SCALE: 1" = 100' PRIOR INSTRUMENT: #970486758

DRH