


PARENT PARCEL: 01-00-013-000-004

CHILD PARCEL: 01-00-013-000-058, -059

STARTING POINT: W SE CORNER LOT 13

NO. 00176

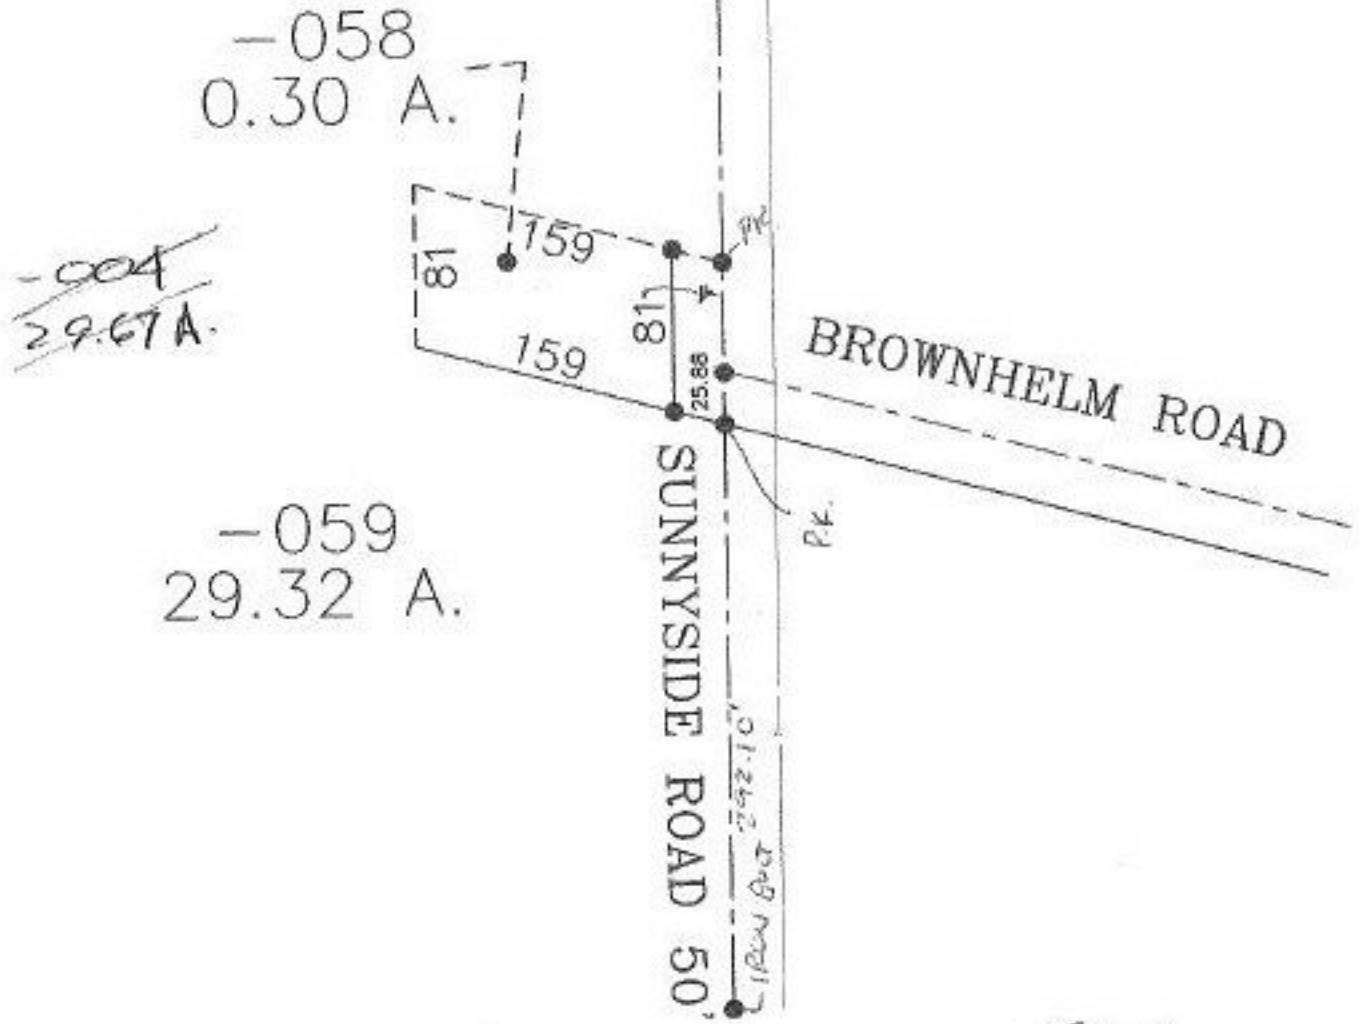

3-29-00



SPLITS/DEEDS PROCESSED

LORAIN COUNTY TAX MAP DEPARTMENT
226 MIDDLE AVE. ELYRIA, OHIO

SURVEYED BY: JAMES A. BROADWAY

CLOSURE: 0.00 : 10.000

MAP PAGE(S): 1-B

APPROVED BY: DRH DATE: 8/6/99

SCALE: 1" = 100' PRIOR INSTRUMENT: OR 1083/807