


PARENT PARCEL: 16-00-075-000-002 & -011  
CHILD PARCEL: XX-XX-XXX-XXX-XXX  
STARTING POINT: MON. BOX, C/L OF LAW RD. & C/L OF WOOSTER-AVON LAKE RD.

NO. 00179-X

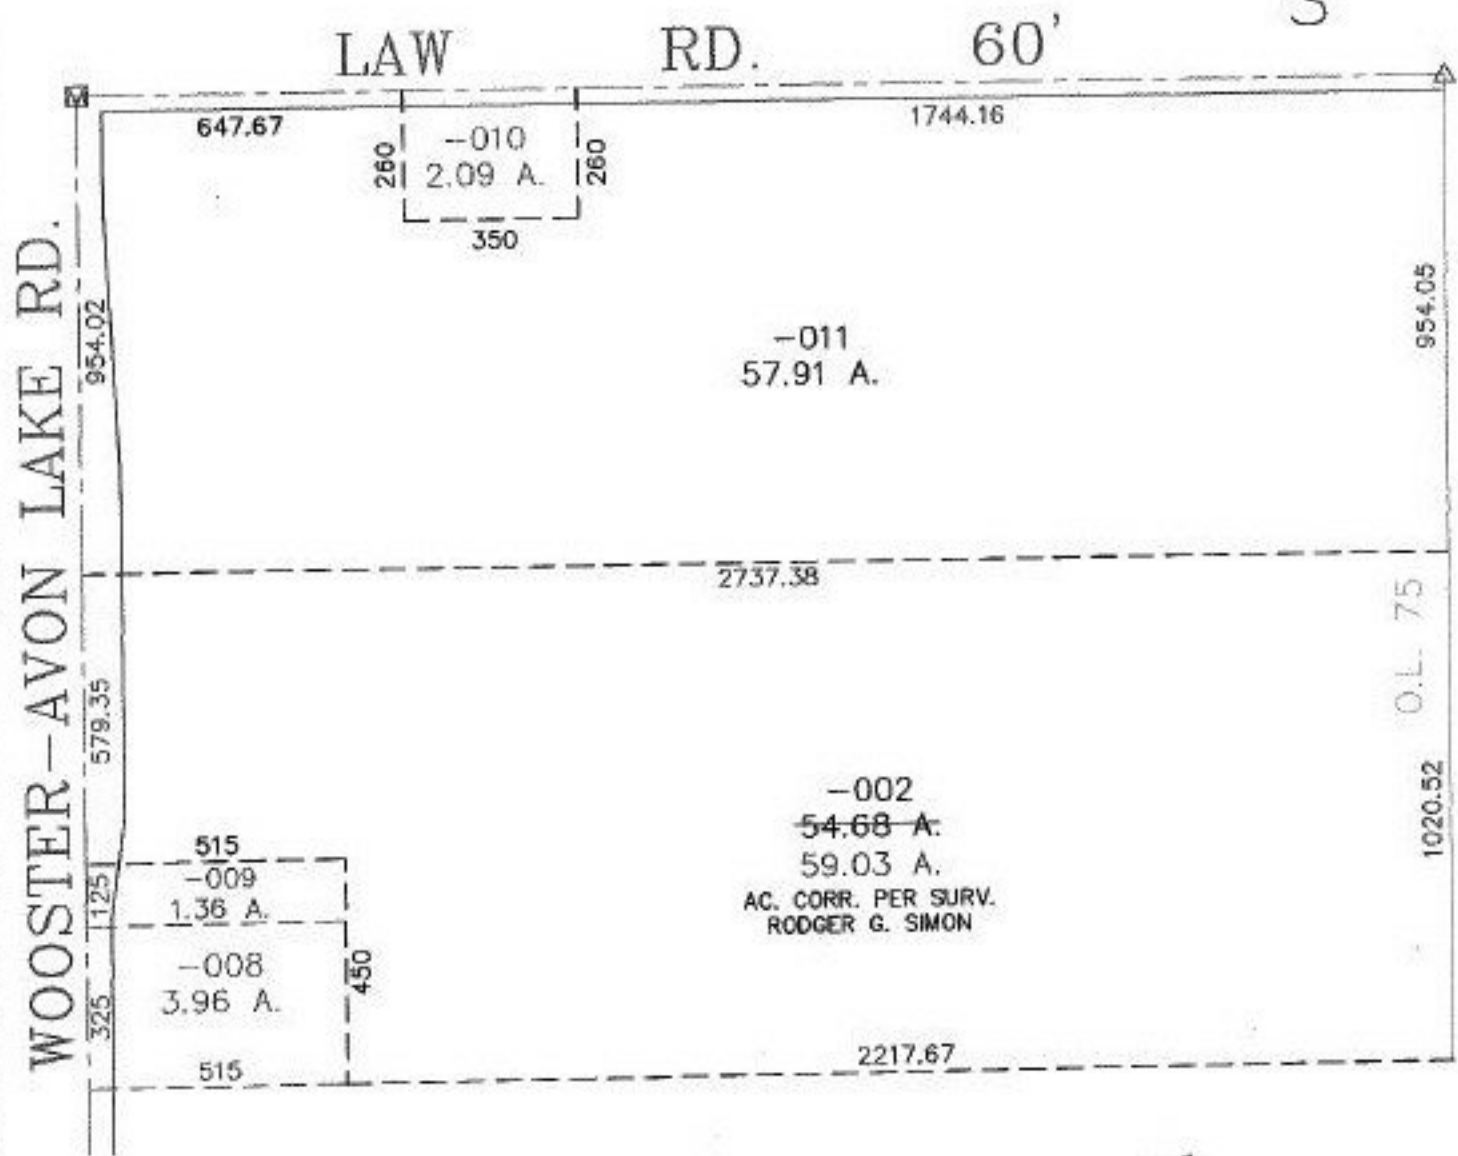


WOOSTER-AVON LAKE RD.

LAW RD. 60'

647.67 1744.16 954.05  
260 -010 260  
2.09 A.  
350  
-011  
57.91 A.  
2737.38  
515  
-009  
1.36 A.  
-008  
3.96 A.  
450  
515  
1020.52  
2217.67

-002  
54.68 A.  
59.03 A.  
AC. CORR. PER SURV.  
RODGER G. SIMON

2-22-00

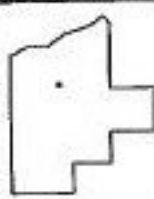

**SPLITS/DEEDS PROCESSED**  
LORAIN COUNTY TAX MAP DEPARTMENT  
226 MIDDLE AVE. ELYRIA, OHIO

SURVEYED BY: RODGER G. SIMON  
CLOSURE: 0.01 : 10,000  
MAP PAGE(S): 16-G  
APPROVED BY: T. SPILLMAN DATE: 07/23/99  
SCALE: 1" = 400' PRIOR INSTRUMENT: OR 99/922