

PARENT PARCEL: 16-00-043-000-001

CHILD PARCEL: 16-00-043-000-024, THRU -029


STARTING POINT: MON BOX CL MENNELL ROAD AT INT S LINE OF OL 38

NO. 00180



O.L. 38

O.L. 43 1947.50

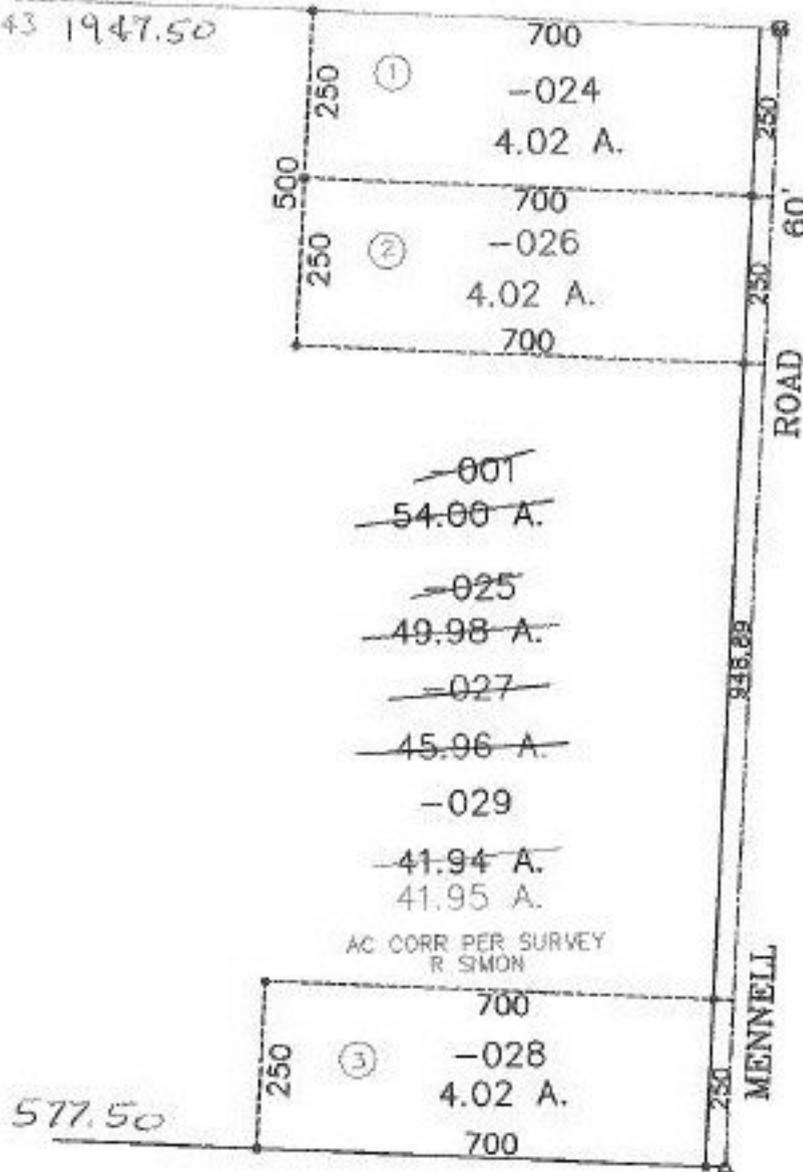

SPLITS/DEEDS PROCESSED
LORAIN COUNTY TAX MAP DEPARTMENT
 226 MIDDLE AVE. ELYRIA, OHIO

SURVEYED BY: RODGER G. SIMON
 CLOSURE: 0.06 : 10,000
 MAP PAGE(S): 16-A
 APPROVED BY: DRH DATE: 8/30/99
 SCALE: 1" = 300' PRIOR INSTRUMENT: DV 1385/102