



PARENT PARCEL: 04-00-008-104-087, 051
 CHILD PARCEL: 04-00-008-104-106, -107, -108
 STARTING POINT: MON BOX CL PIN OAK PWY AT ANGLE POINT

NO. 00185

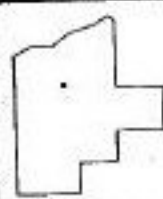

Moore Rd.

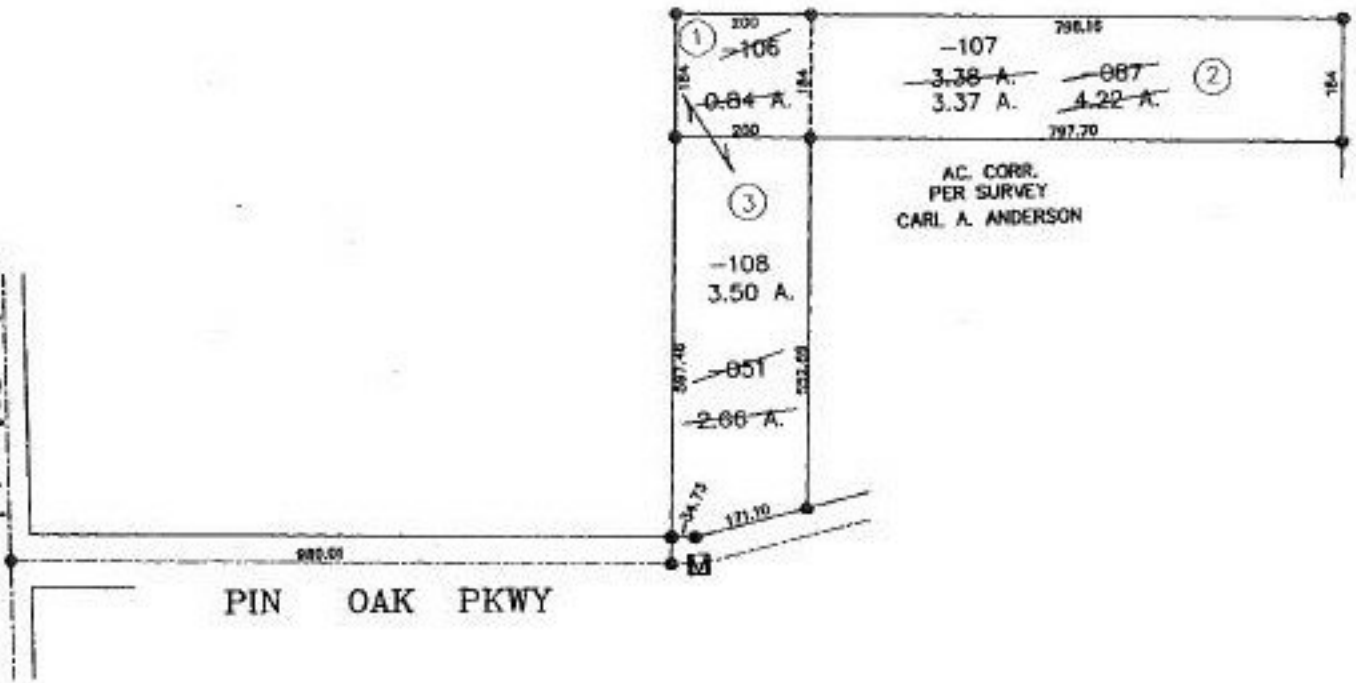

SPLITS/DEEDS PROCESSED
 LORAIN COUNTY TAX MAP DEPARTMENT
 226 MIDDLE AVE. ELYRIA, OHIO

SURVEYED BY: CARL A. ANDERSON
 CLOSURE: 0.00 : 10.000
 MAP PAGE(S): 4-B
 APPROVED BY: DRH DATE: 9/10/99
 SCALE: 1" = 300' PRIOR INSTRUMENT: OR 1265/570