
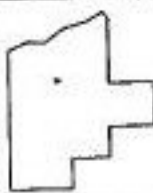


PARENT PARCEL: 15-00-015-000-005, -006  
 CHILD PARCEL: 15-00-015-000-007, -008, -009, -010  
 STARTING POINT: CL LAGRANGE ROAD AT SW CORNER O.L. 15

NO. 00191

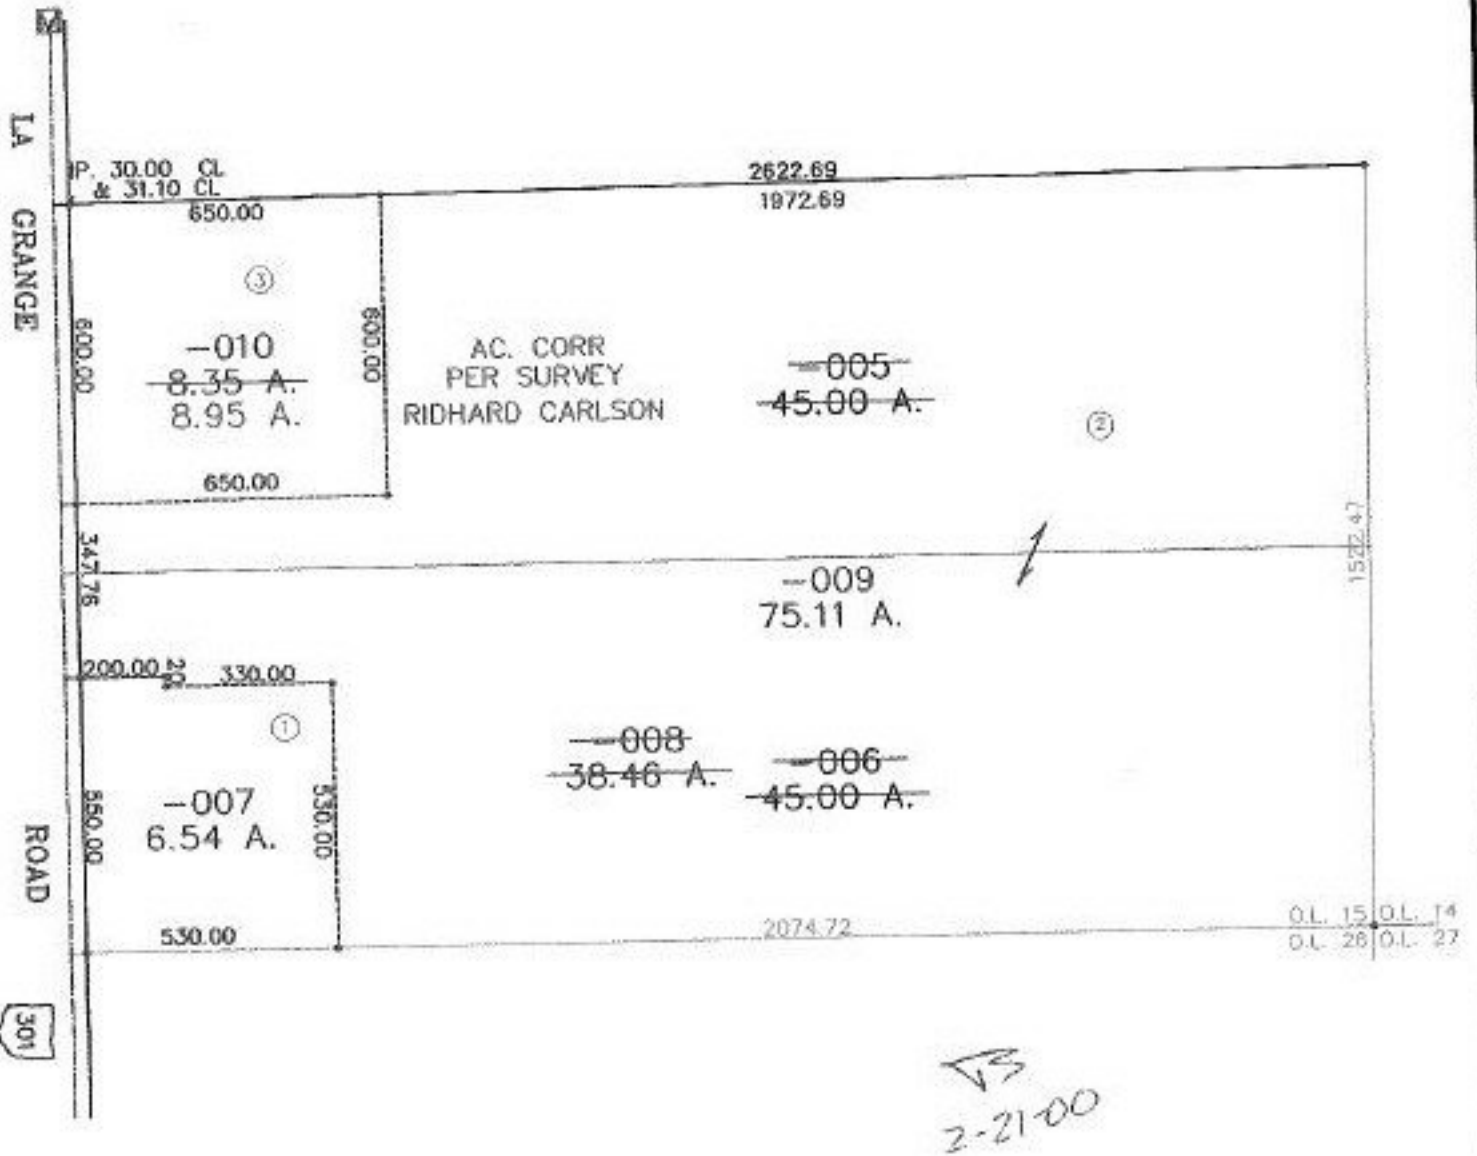

**SPLITS/DEEDS PROCESSED**  
 LORAIN COUNTY TAX MAP DEPARTMENT  
 226 MIDDLE AVE. ELYRIA, OHIO

SURVEYED BY: RICHARD D. CARLSON  
 CLOSURE: 0.00 : 10.000  
 MAP PAGE(S): 15-C  
 APPROVED BY: DRH DATE: 8/24/99  
 SCALE: 1" = 400' PRIOR INSTRUMENT: 990630794