



PARENT PARCEL: 01-00-053-000-018, 019  
CHILD PARCEL: 01-00-053-000-037, -038, -039  
STARTING POINT: PK NAIL CL OF CLAUS RD

NO. 00195

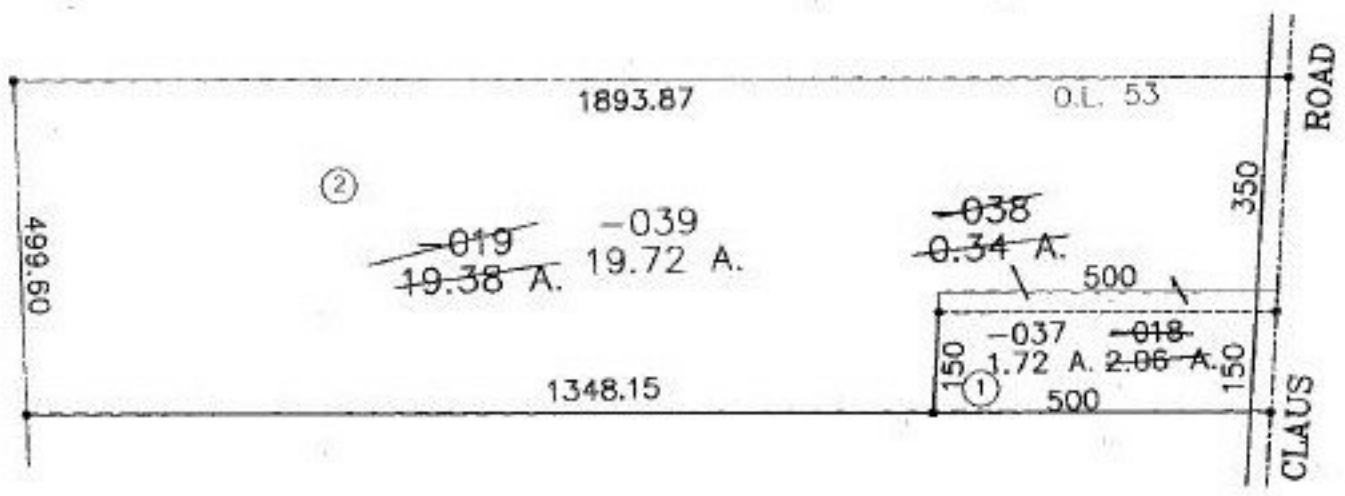

PRIOR INSTRUMENT: OR 270/653  
PRIOR INSTRUMENT: OR 181/633

SURVEYED BY: M. G. HURA  
CLOSURE: 0.00 : 10.000  
MAP PAGE(S): 01-00-053-A  
APPROVED BY: DRH DATE: 9/1/99  
SCALE: 1" = 300

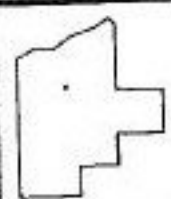

**SPLITS/DEEDS PROCESSED**  
LORAIN COUNTY TAX MAP DEPARTMENT  
226 MIDDLE AVE. ELYRIA, OHIO