

PARENT PARCEL: 05-00-001-000-012

CHILD PARCEL: XX-XX-XXX-XXX-XXX

STARTING POINT: CL. OF COOPER FOSTER PARK RD. &

THE S.W. CORNER OF LAND CONVEYED TO HENCEROOTH

NO. 00196-A




ACREAGE CORRECTION

05-00-001-000-012

~~8.97 A.~~

8.93 A.

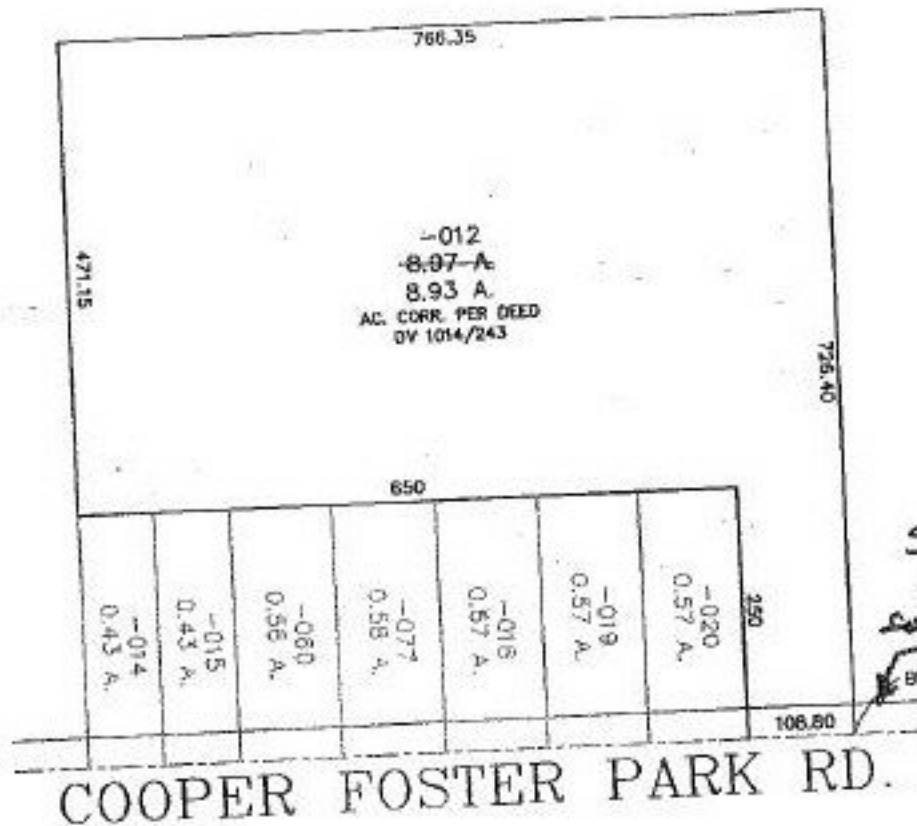

SW CORNER
DV 685/235
for principal place of

BEGINNING

COOPER FOSTER PARK RD.



SPLITS/DEEDS PROCESSED
LORAIN COUNTY TAX MAP DEPARTMENT
226 MIDDLE AVE. ELYRIA, OHIO

SURVEYED BY: NONE
CLOSURE: CAN'T RUN
MAP PAGE(S): 05-00-001-B
APPROVED BY: T. SPILLMAN DATE: 09/09/99
SCALE: 1" = 200' PRIOR INSTRUMENT: DV 1014/243