
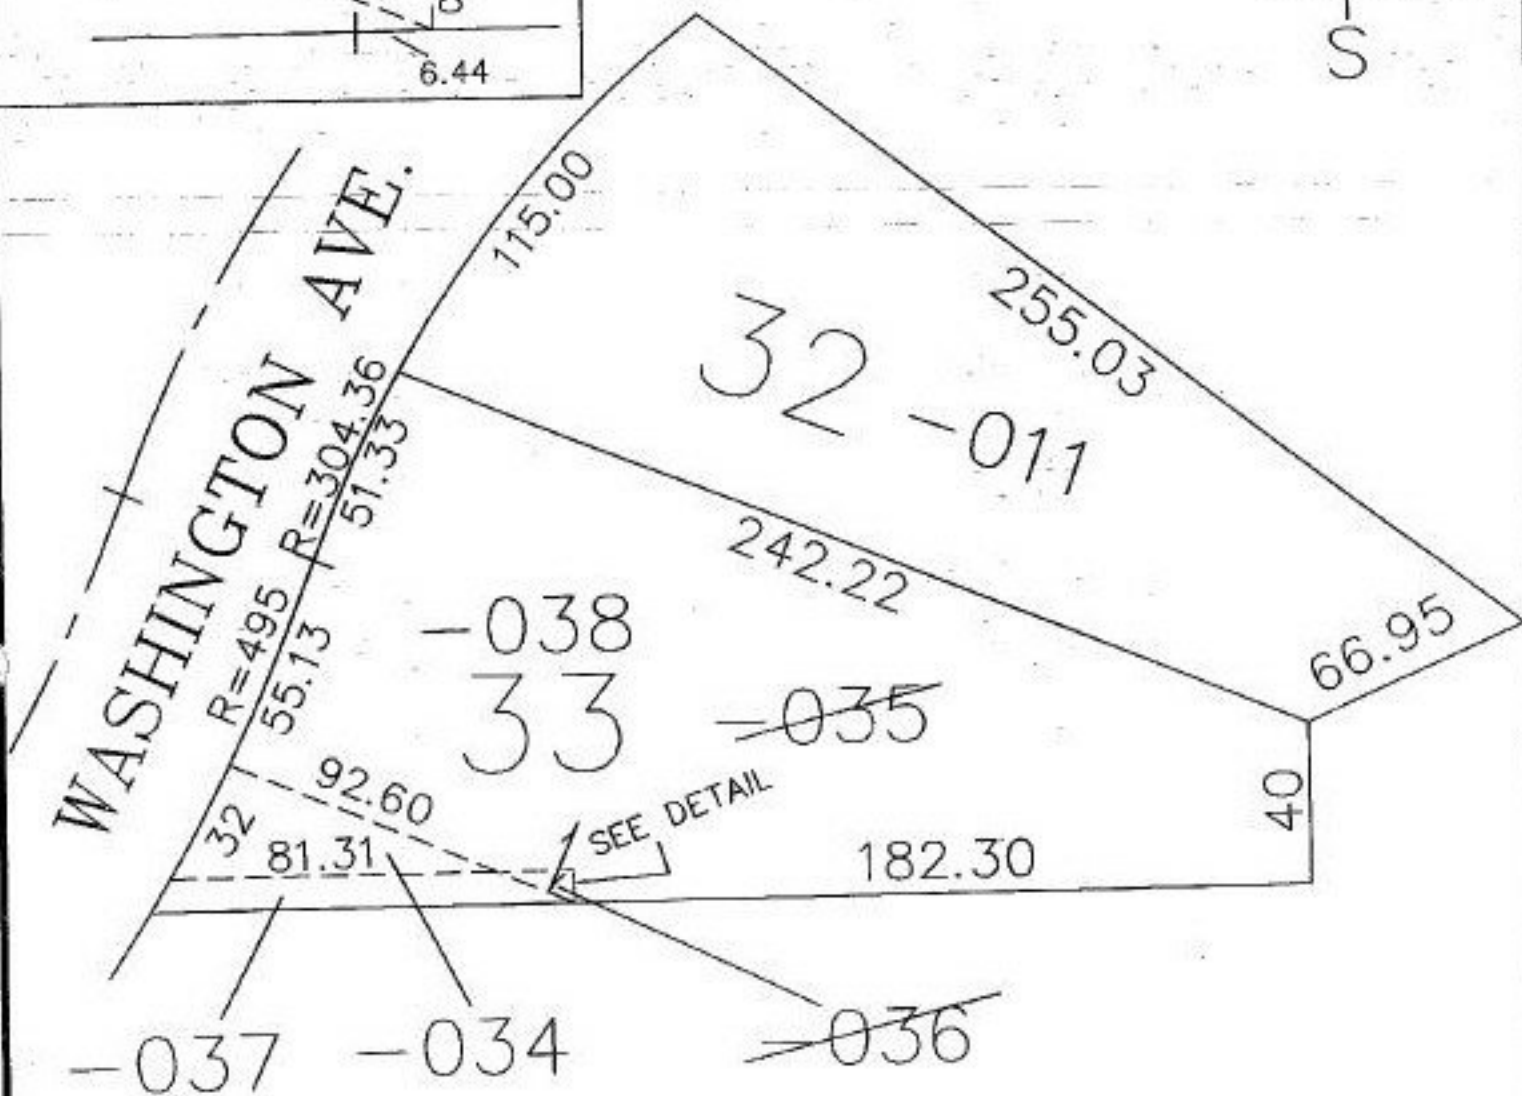


PARENT PARCEL: 06-25-158-000-035, -036
CHILD PARCEL: 06-25-158-000-038
STARTING POINT: IP SET AT SW CORNER OF O.L. 32

NO. 00196

DETAIL NOT TO SCALE

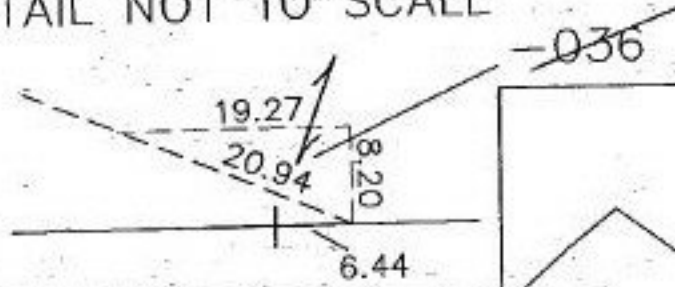

SPLITS/DEEDS PROCESSED
LORAIN COUNTY TAX MAP DEPARTMENT
226 MIDDLE AVE. ELYRIA, OHIO

SURVEYED BY: RODGER G. SIMON
CLOSURE: 46 : 10.000
MAP PAGE(S): 6-102
APPROVED BY: DRH DATE: 9/10/99
SCALE: 1" = 50' PRIOR INSTRUMENT: OR 306/208