


PARENT PARCEL: 18-00-020-000-090

CHILD PARCEL: 18-00-020-000-113 & -114

STARTING POINT: CL OF PECK-WADSWORTH RD. & CL OF ASHLAND-OBERLIN RD.

NO. 00201

PECK-WADSWORTH RD.

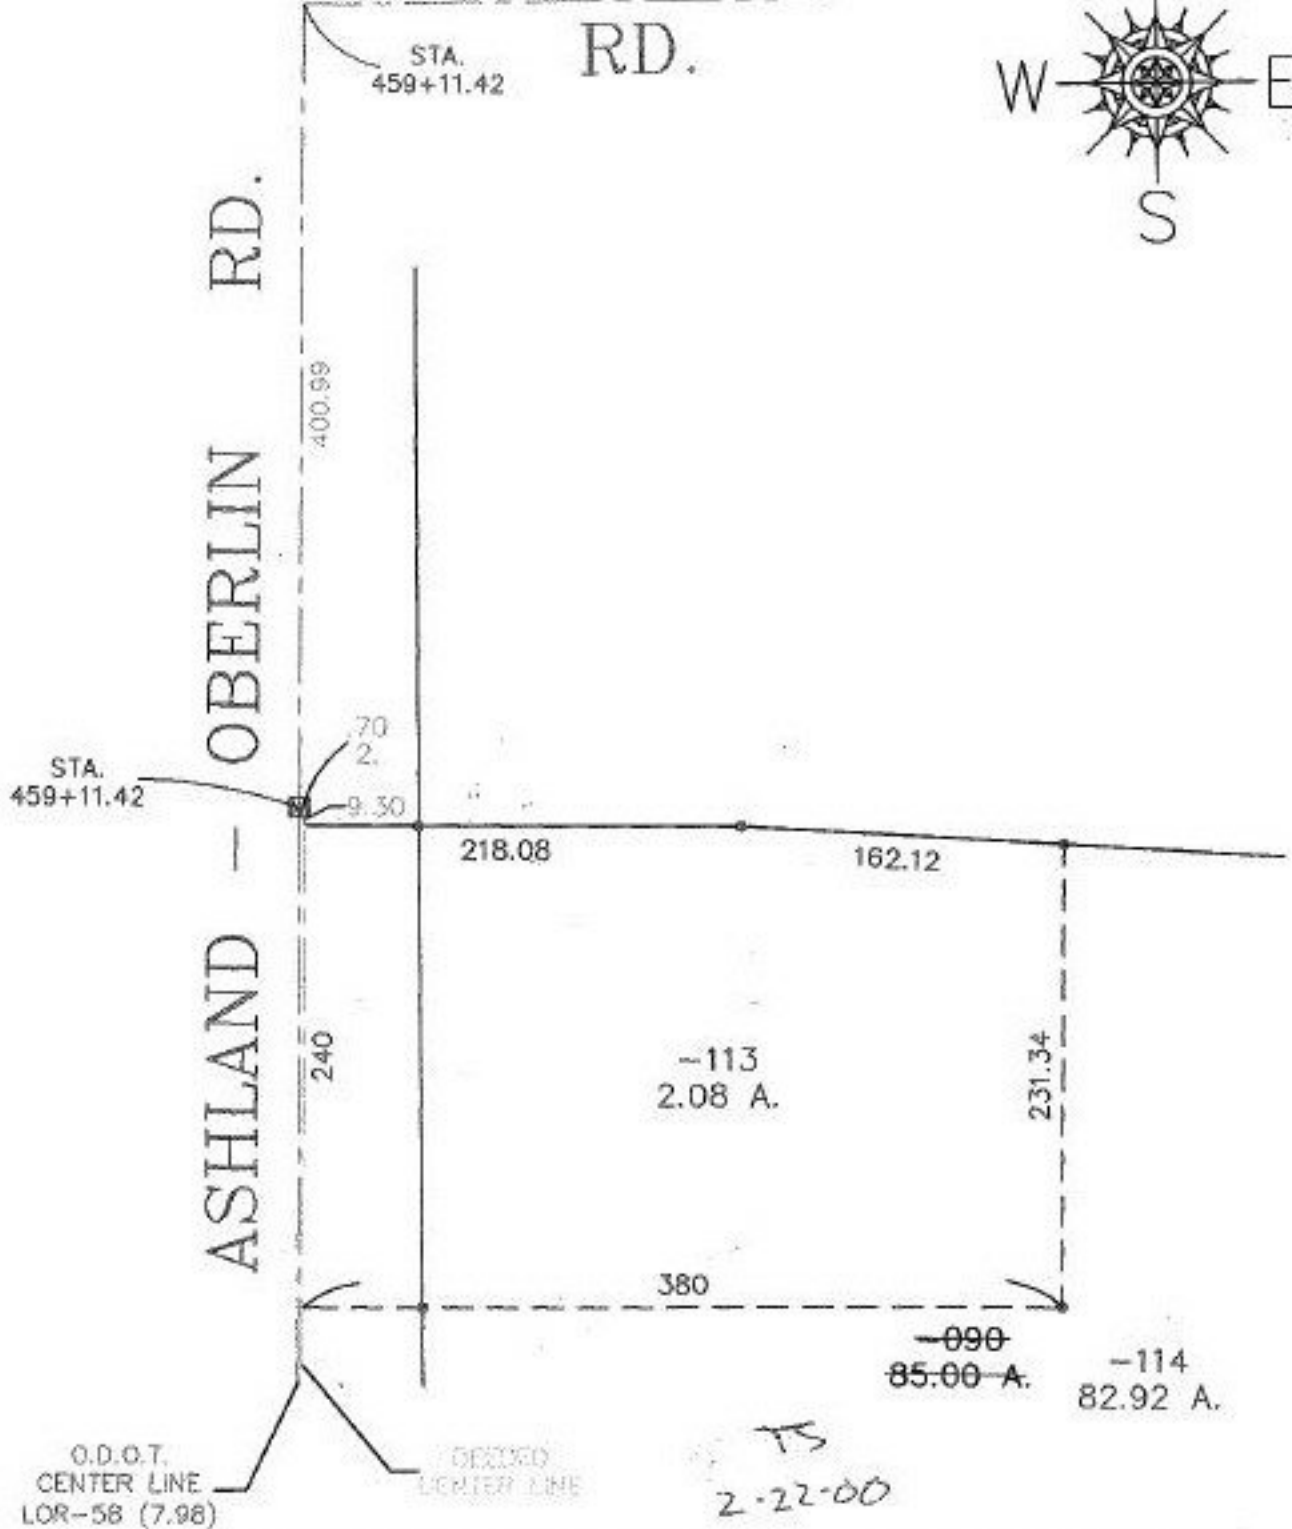

SPLITS/DEEDS PROCESSED

LORAIN COUNTY TAX MAP DEPARTMENT
226 MIDDLE AVE. ELYRIA, OHIO

SURVEYED BY: BRIAN P. McCARTNEY

CLOSURE: 0.01 : 10.000

MAP PAGE(S): 18-00-020-A & B

APPROVED BY: I. SPILLMAN DATE: 09/17/99

SCALE: 1" = 100' PRIOR INSTRUMENT: OR 258/824