

PARENT PARCEL: 07-00-044-103-046


CHILD PARCEL: 07-00-044-103-051 & -052

STARTING POINT: I.P. MON. BOX, CL OF CASE RD. & CL OF BURNS RD.

NO. 00204



BURNS RD.

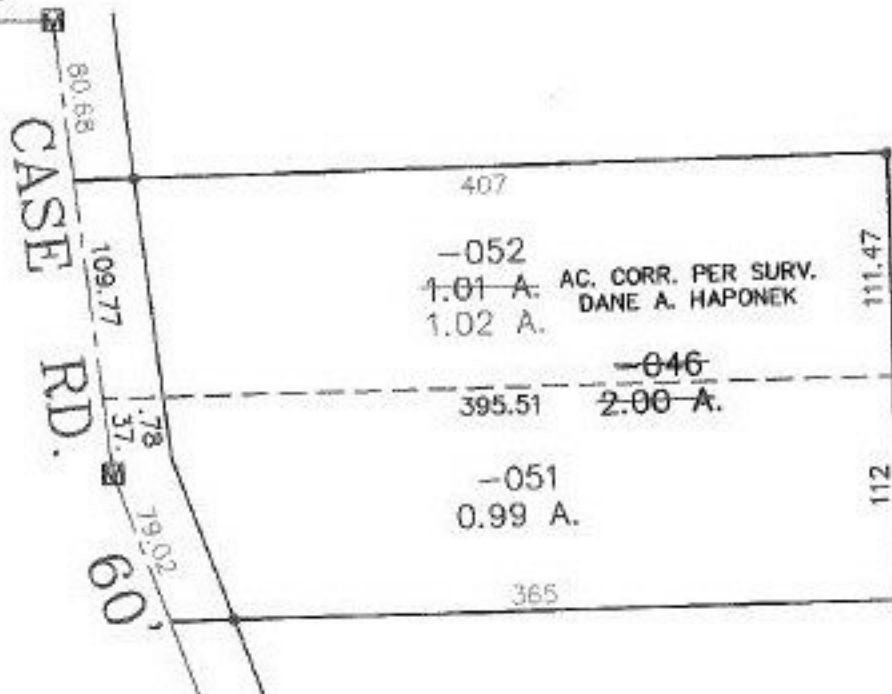

SPLITS/DEEDS PROCESSED

LORAIN COUNTY TAX MAP DEPARTMENT
226 MIDDLE AVE. ELYRIA, OHIO

SURVEYED BY: DANE A. HAPONEK

CLOSURE: 0.06 : 10.000

MAP PAGE(S): 07-00-044-A

APPROVED BY: I. SPILLMAN DATE: 10/05/99

SCALE: 1" = 100' PRIOR INSTRUMENT: 980578555