


PARENT PARCEL: 10-00-002-000-028

CHILD PARCEL: XX-XX-XXX-XXX-XXX


STARTING POINT: CL OF RUSSIA RD. & S.E. CORNER OF O.L. 2

NO. 00205-X

MAP CORRECTION ONLY

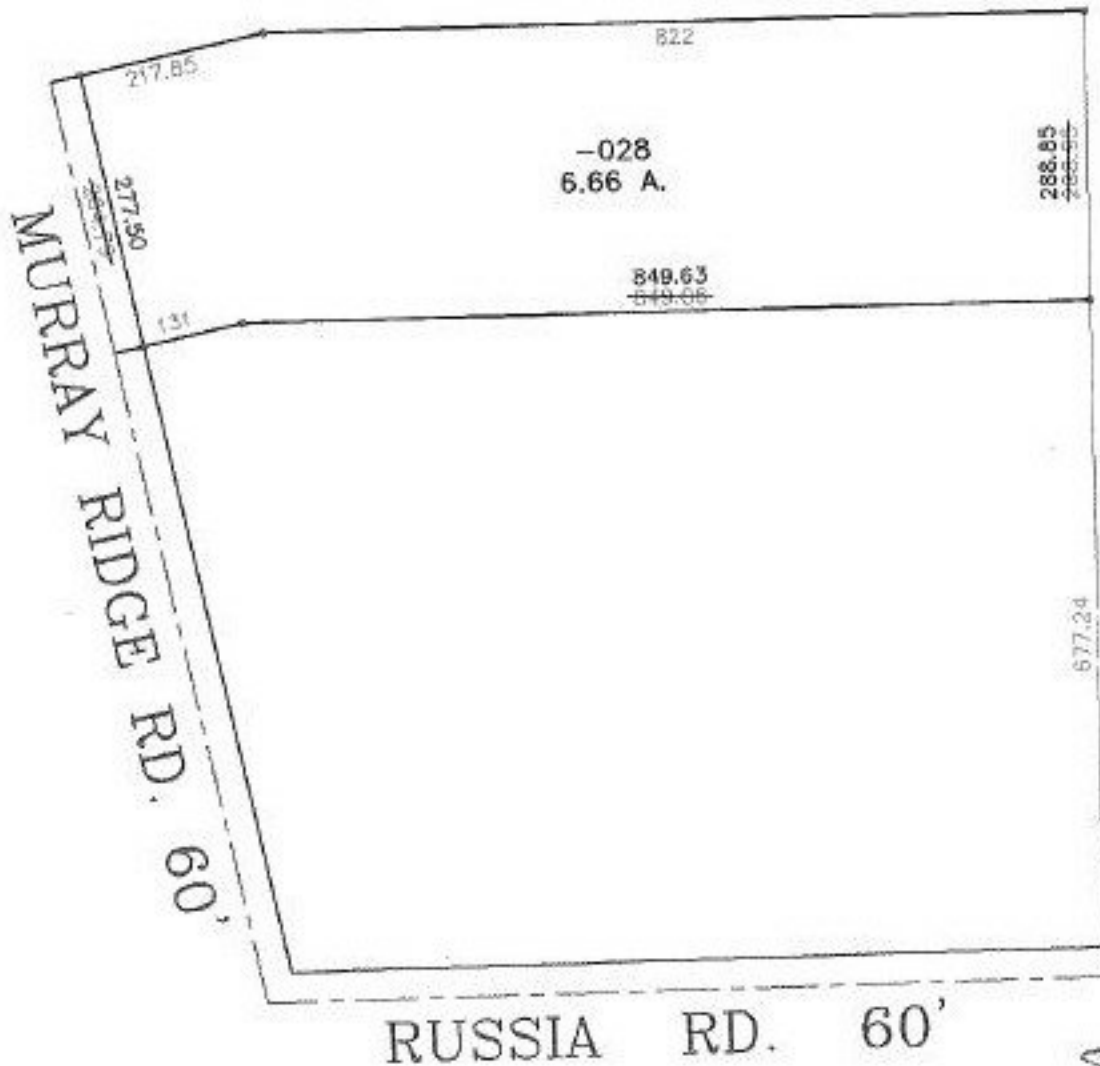

2-16-00

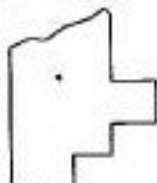

SPLITS/DEEDS PROCESSED

LORAIN COUNTY TAX MAP DEPARTMENT
226 MIDDLE AVE. ELYRIA, OHIO

SURVEYED BY: C. E. PENFOUND

CLOSURE: 1.82 : 10.000

MAP PAGE(S): 10-B

APPROVED BY: I. SPILLMAN DATE: 10/05/99

SCALE: 1" = 200' PRIOR INSTRUMENT: DV 1253/709