


PARENT PARCEL: 05-00-032-000-102, -103, -104, -049, -052

CHILD PARCEL: 05-00-032-000-107

STARTING POINT: INT OF CL MILAN RD AND WESTERLY LINE OF O.L. 32

NO. 00205

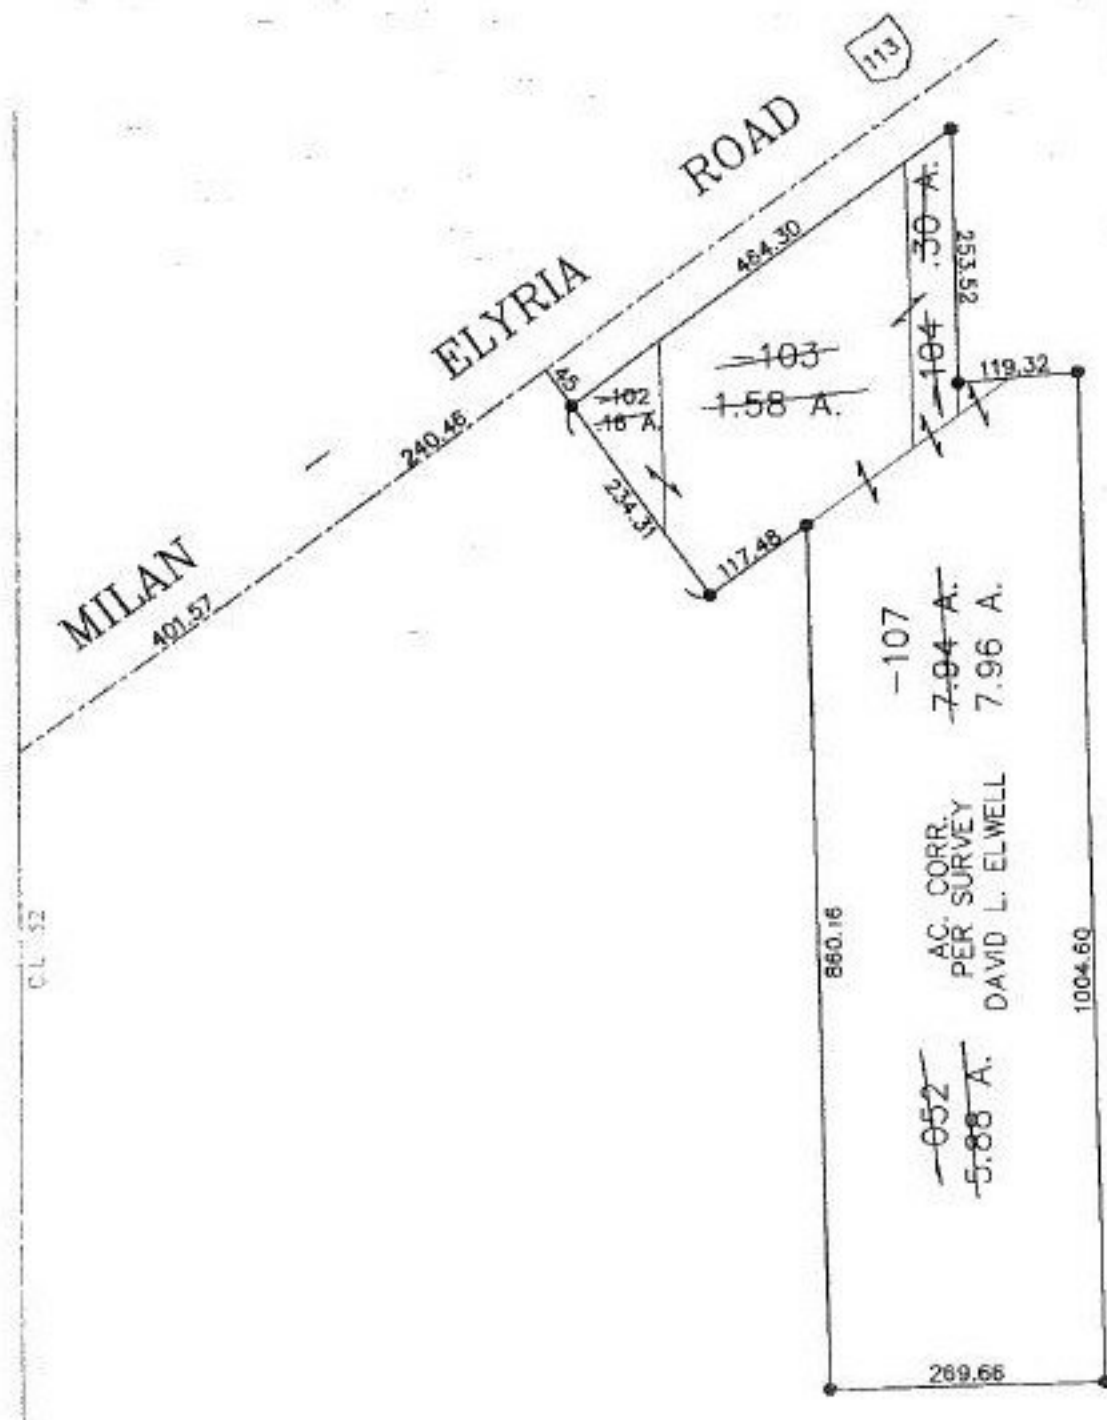

SPLITS/DEEDS PROCESSED
 LORAIN COUNTY TAX MAP DEPARTMENT
 226 MIDDLE AVE. ELYRIA, OHIO

SURVEYED BY: DAVID L. ELWELL
 CLOSURE: 0.03 : 10.000
 MAP PAGE(S): 05-00-032-A
 APPROVED BY: DRH DATE: 9/15/99
 SCALE: 1" = 200' PRIOR INSTRUMENT: OR 1149/624