


-038-A

SEE
FOR
MON
BOX

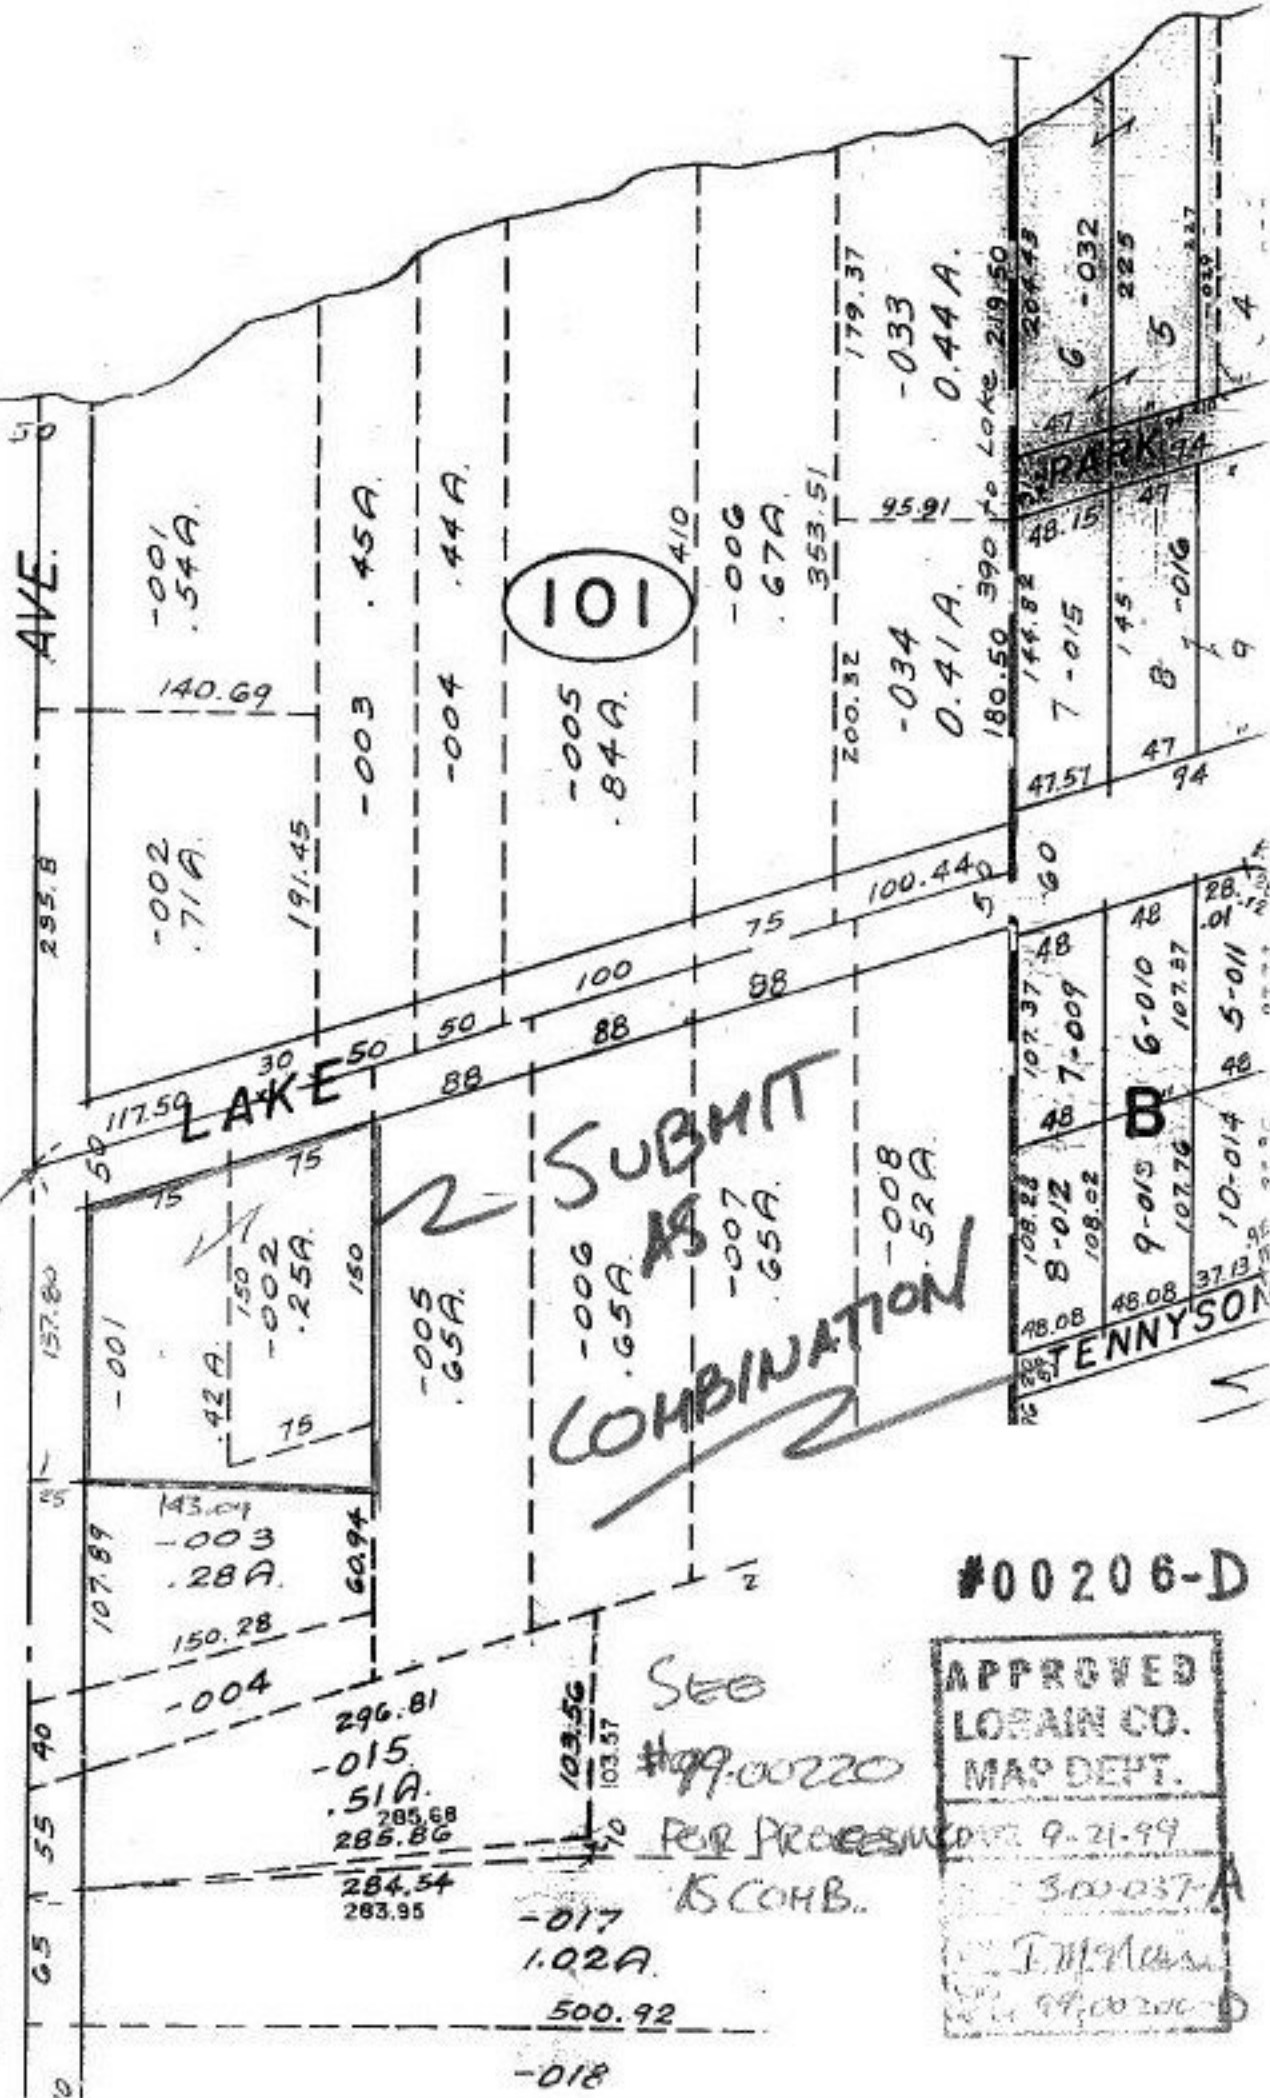

101

SUBMIT
AS
COMBINATION

TENNYSON

#00206-D

APPROVED
 LOHAIN CO.
 MAP DEPT.
 9-21-99
 300-037-A
 J.M. News
 #99-00206-D

See #99-00220

FOR PROCESSING

AS COMB.

-017
1.02A

500.92

-018

296.81
-015
.51A
285.68
285.86

284.54
283.95

103.56
103.57

9-21-99

300-037-A

J.M. News

#99-00206-D