


PARENT PARCEL: 16-00-019-101-005

CHILD PARCEL: 16-00-019-101-005

STARTING POINT: SW CORNER O.L. 19

NO. 00207-A

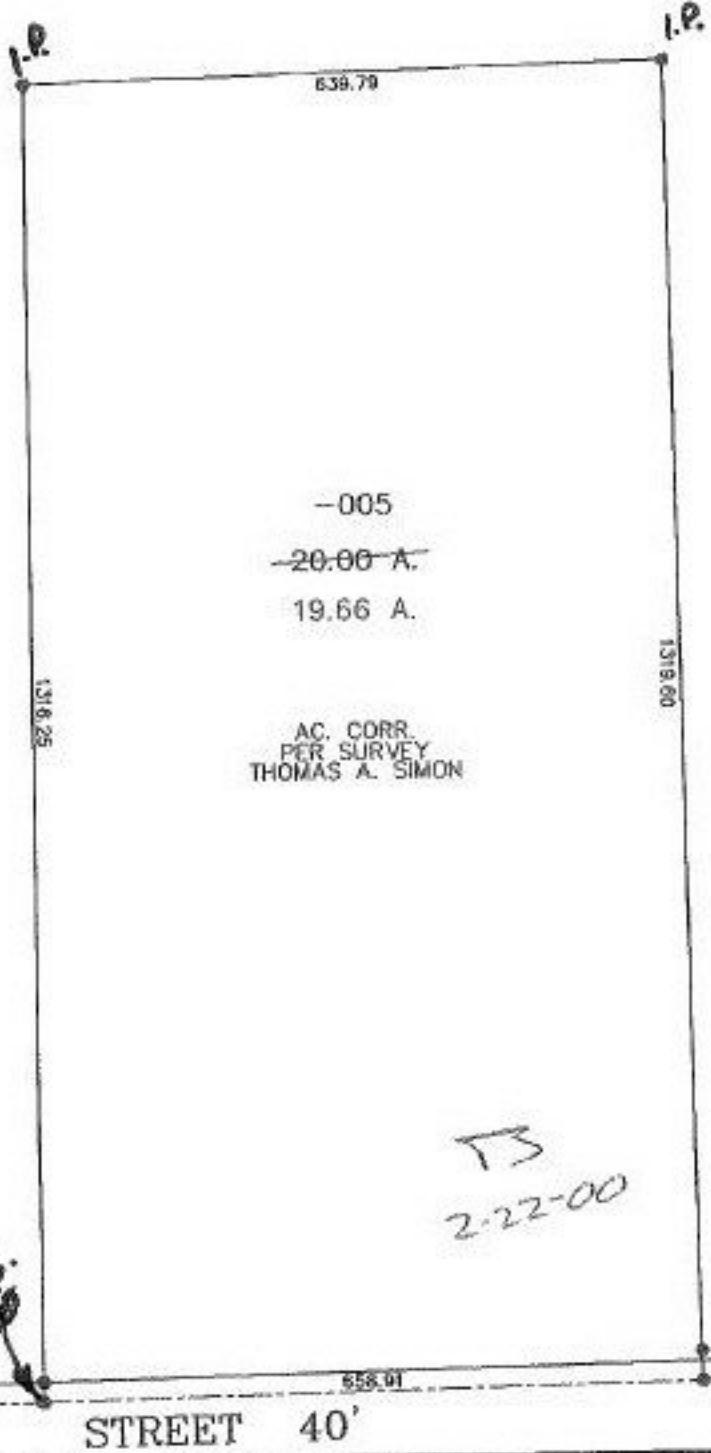


-005
~~-20.00 A.~~
19.66 A.

AC. CORR.
PER SURVEY
THOMAS A. SIMON

SW CORNER
OL 16

P.P.S.
30

TS
2-22-00

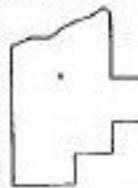

SPLITS/DEEDS PROCESSED
LORAIN COUNTY TAX MAP DEPARTMENT
226 MIDDLE AVE. ELYRIA, OHIO

SURVEYED BY: THOMAS A. SIMON
CLOSURE: 0.02 : 10,000
MAP PAGE(S): 16-A
APPROVED BY: DRH DATE: 10/6/99
SCALE: 1" = 200' PRIOR INSTRUMENT: CR 1366/630

CR 1366/630