


E 7-00-027-B

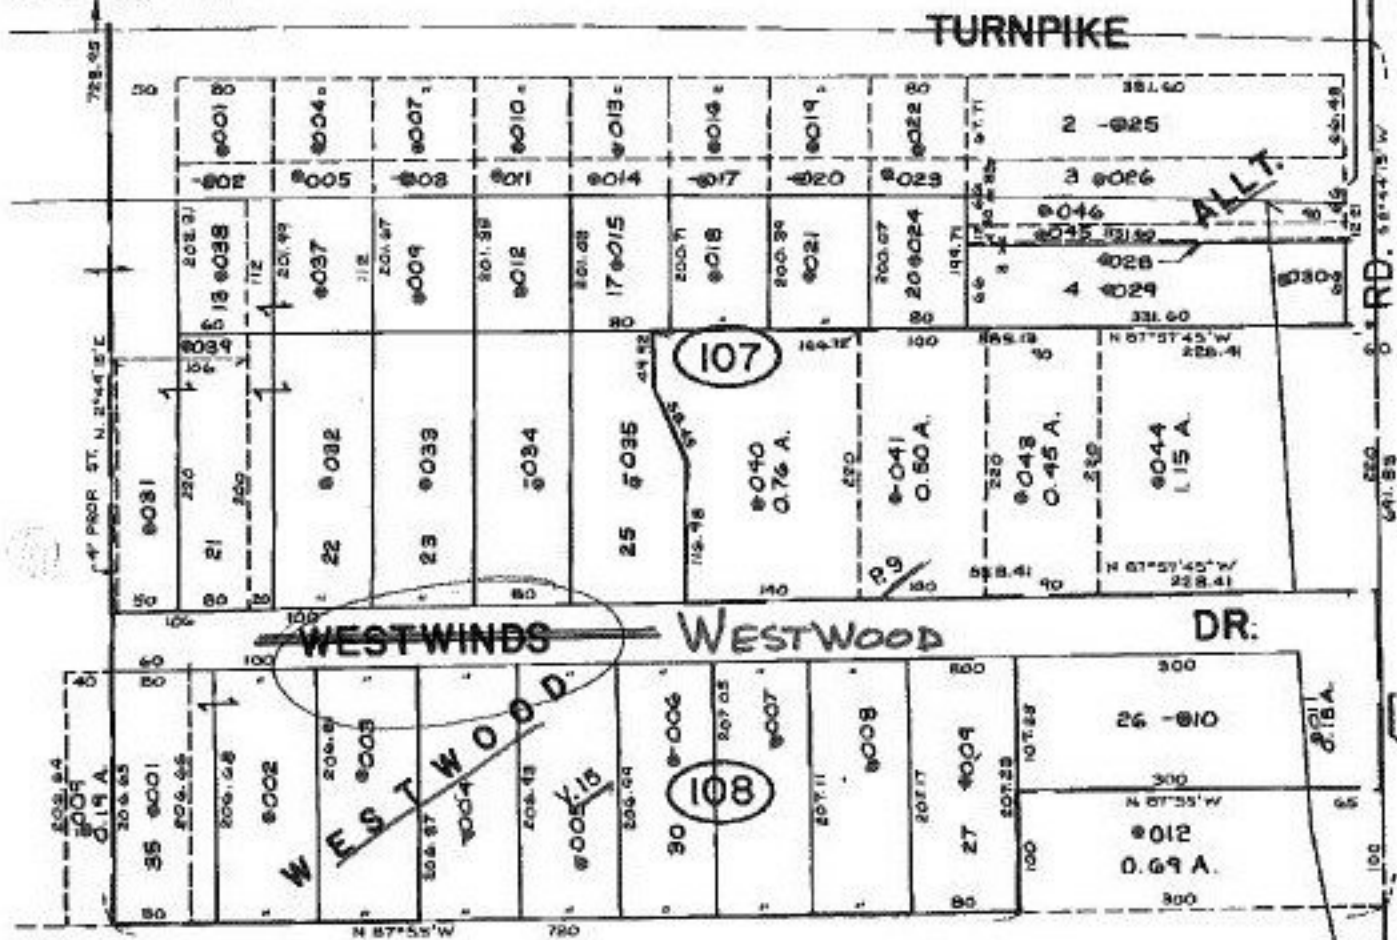

NAME CORRECTION DER
PLAT VOL. 15, P. 9

83

SEE 7-00-022-C

99 212-A

APPROVED
LORAIN CO.
MAP DEPT.
DATE 10.5.99
FILE 7-00-027-A
BY T.SPILLMAN
99100212A

