

PARENT PARCEL: 14-00-141-000-006 & -007

CHILD PARCEL: 14-00-141-000-008 THRU -010

STARTING POINT: MON. BOX, CL. OF WEST RD. & THE NORTH LINE OF O.L. 141


NO. 00214

WEST RD. 60'

DETAIL
NO SCALE



TS
A-6-00

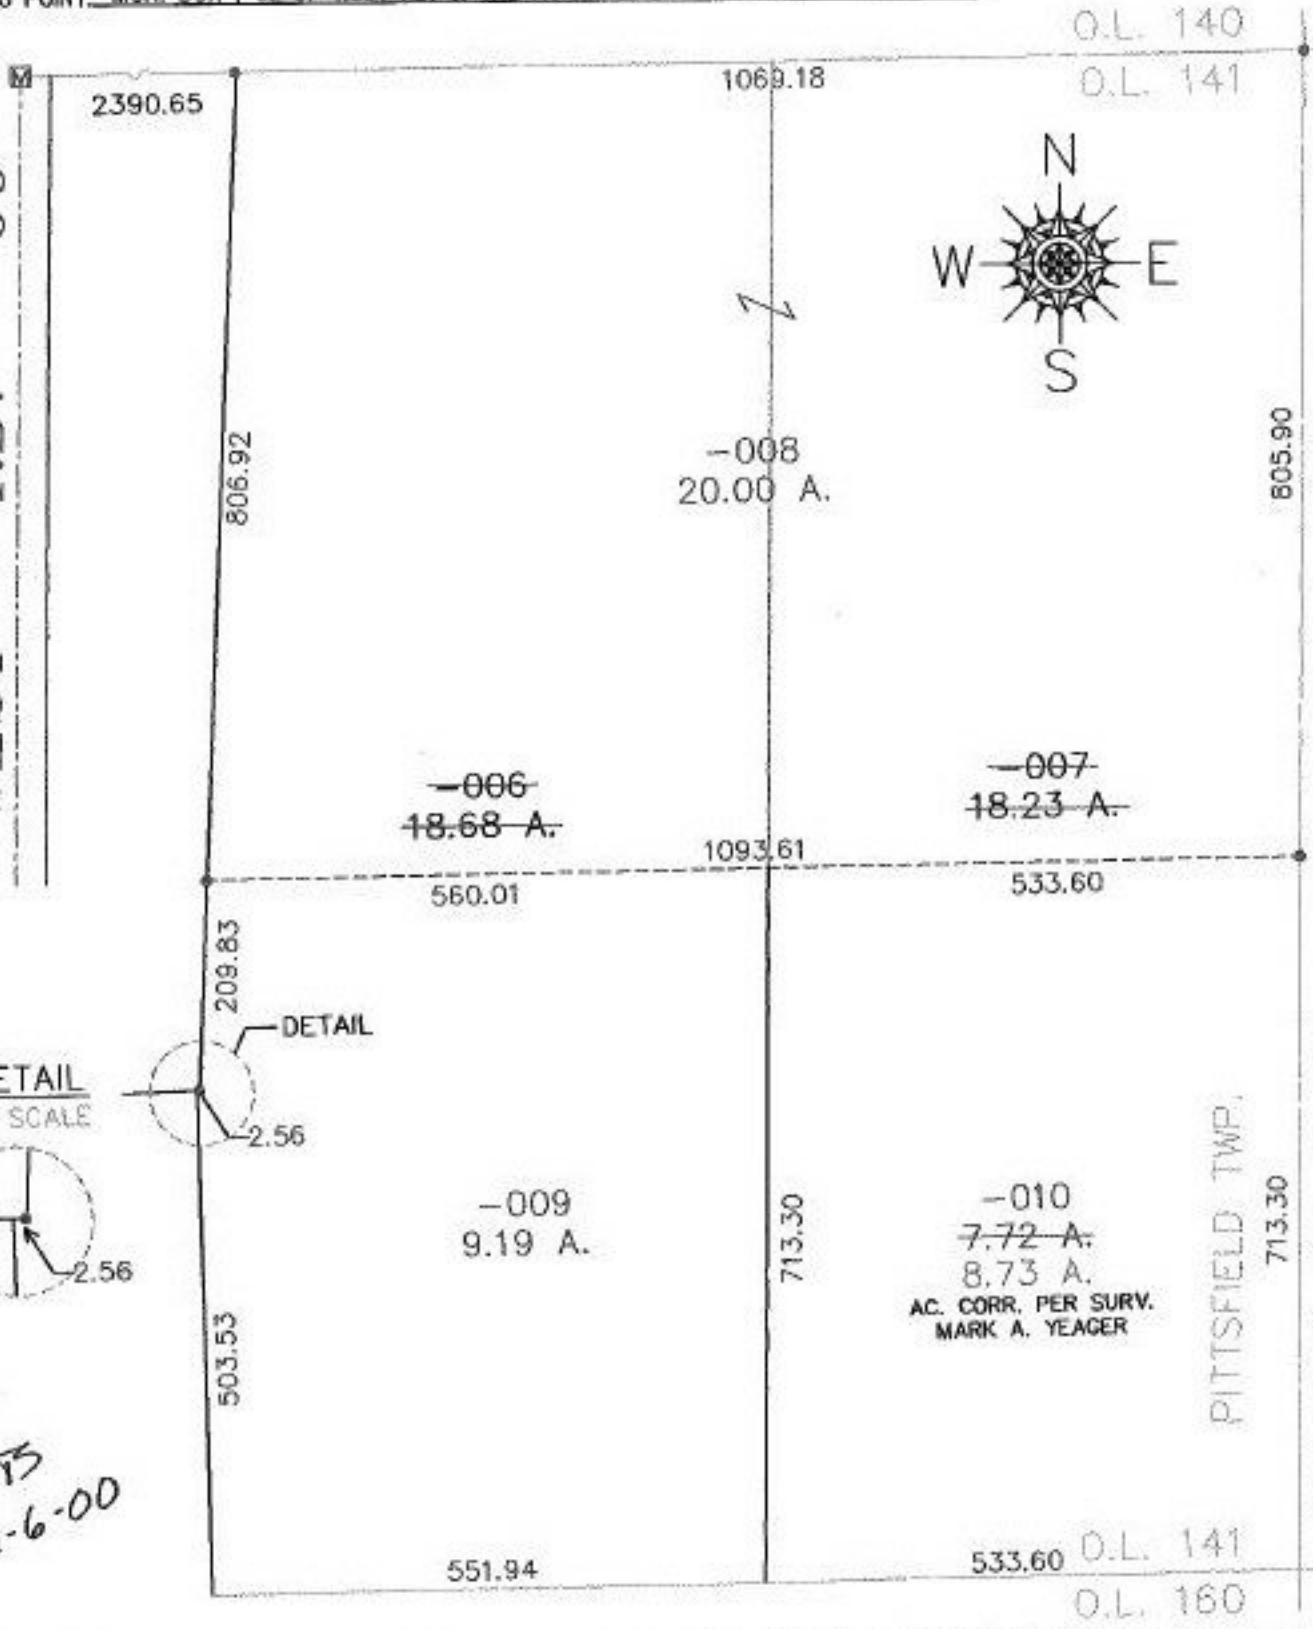

SPLITS/DEEDS PROCESSED

LORAIN COUNTY TAX MAP DEPARTMENT
226 MIDDLE AVE. ELYRIA, OHIO

SURVEYED BY: MARK A. YEAGER
CLOSURE: 0.02 : 10,000
MAP PAGE(S): 14-H
APPROVED BY: I. SPILLMAN DATE: 12/7/99
SCALE: 1" = 200' PRIOR INSTRUMENT: OR 1152/533