

PARENT PARCEL: 12-00-002-000-042

CHILD PARCEL: 12-00-002-000-043 & -044

STARTING POINT: CL OF REDFERN RD. & CL OF MARKS RD.

NO. 00218-D

UNCOMBINATION

~~12-00-002-000-042~~
4.40 A.


12-00-002-000-043
3.88 A.

12-00-002-000-044
~~0.52 A.~~
0.50 A.

AC. CORR. PER DEED
990643092



REDFERN RD. 60'

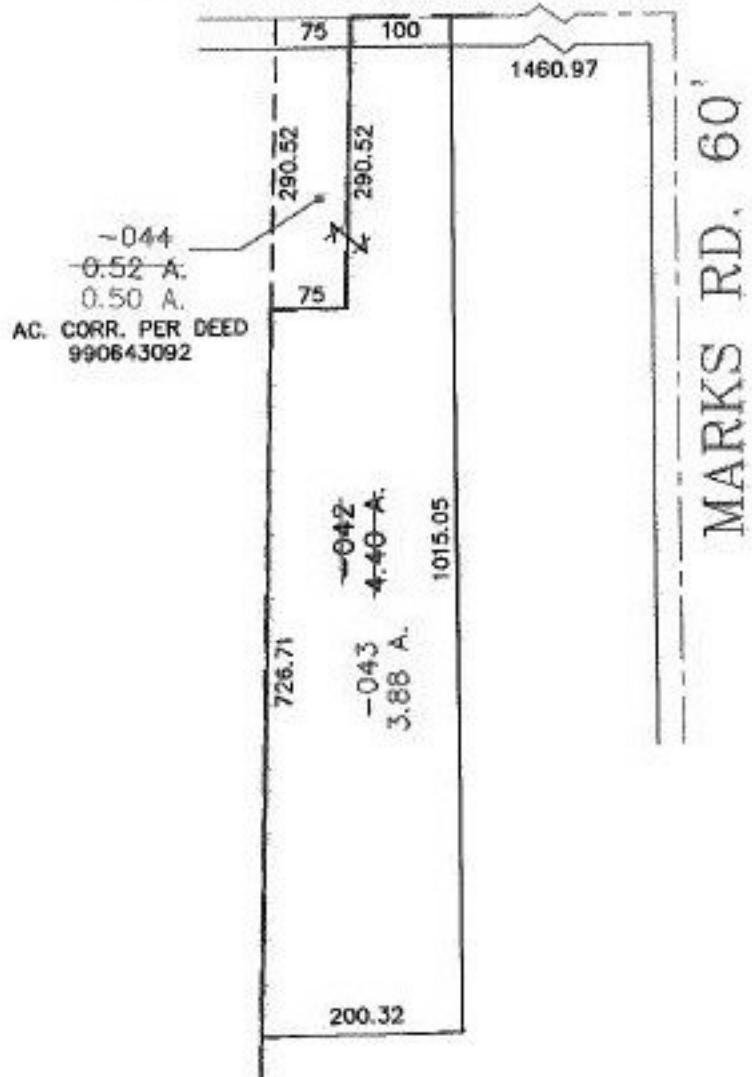

SPLITS/DEEDS PROCESSED
LORAIN COUNTY TAX MAP DEPARTMENT
226 MIDDLE AVE. ELYRIA, OHIO

SURVEYED BY: L. L. DEAN
CLOSURE: 0.00 : 10.000
MAP PAGE(S): 12-00-002-B
APPROVED BY: I. SPILLMAN DATE: 10/12/99
SCALE: 1" = 200' PRIOR INSTRUMENT: 990643092