


PARENT PARCEL: 03-00-037-102-001 & -002


CHILD PARCEL: 03-00-037-102-086

STARTING POINT: SONE MARKER IN A MON. BOX, CL OF LAKE RD. & CL OF HARRIS RD.

NO. 00220

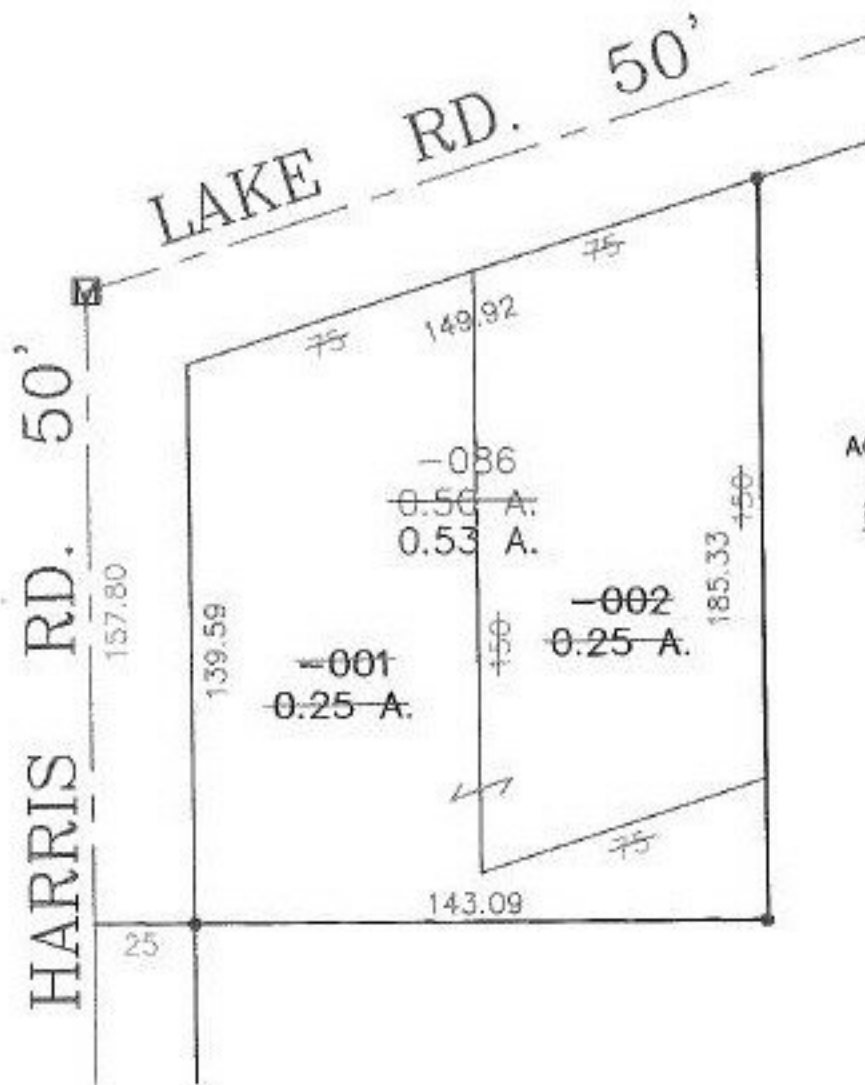

AC. CORR. PAR SURV.
DOUGLAS MOSLEY
BRAMBLE ENG. & SURV.

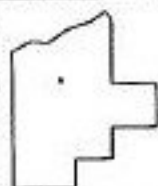

SPLITS/DEEDS PROCESSED
LORAIN COUNTY TAX MAP DEPARTMENT
226 MIDDLE AVE. ELYRIA, OHIO

SURVEYED BY: DOUGLAS MOSLEY
CLOSURE: 0.11 : 10.000
MAP PAGE(S): 03-00-037-A
APPROVED BY: T. SPILLMAN DATE: 09/27/99
SCALE: 1" = 50' PRIOR INSTRUMENT: 990620591