


SEE

To W. Line North Colby  
495.50 ft.

# LORAIN

ST 6

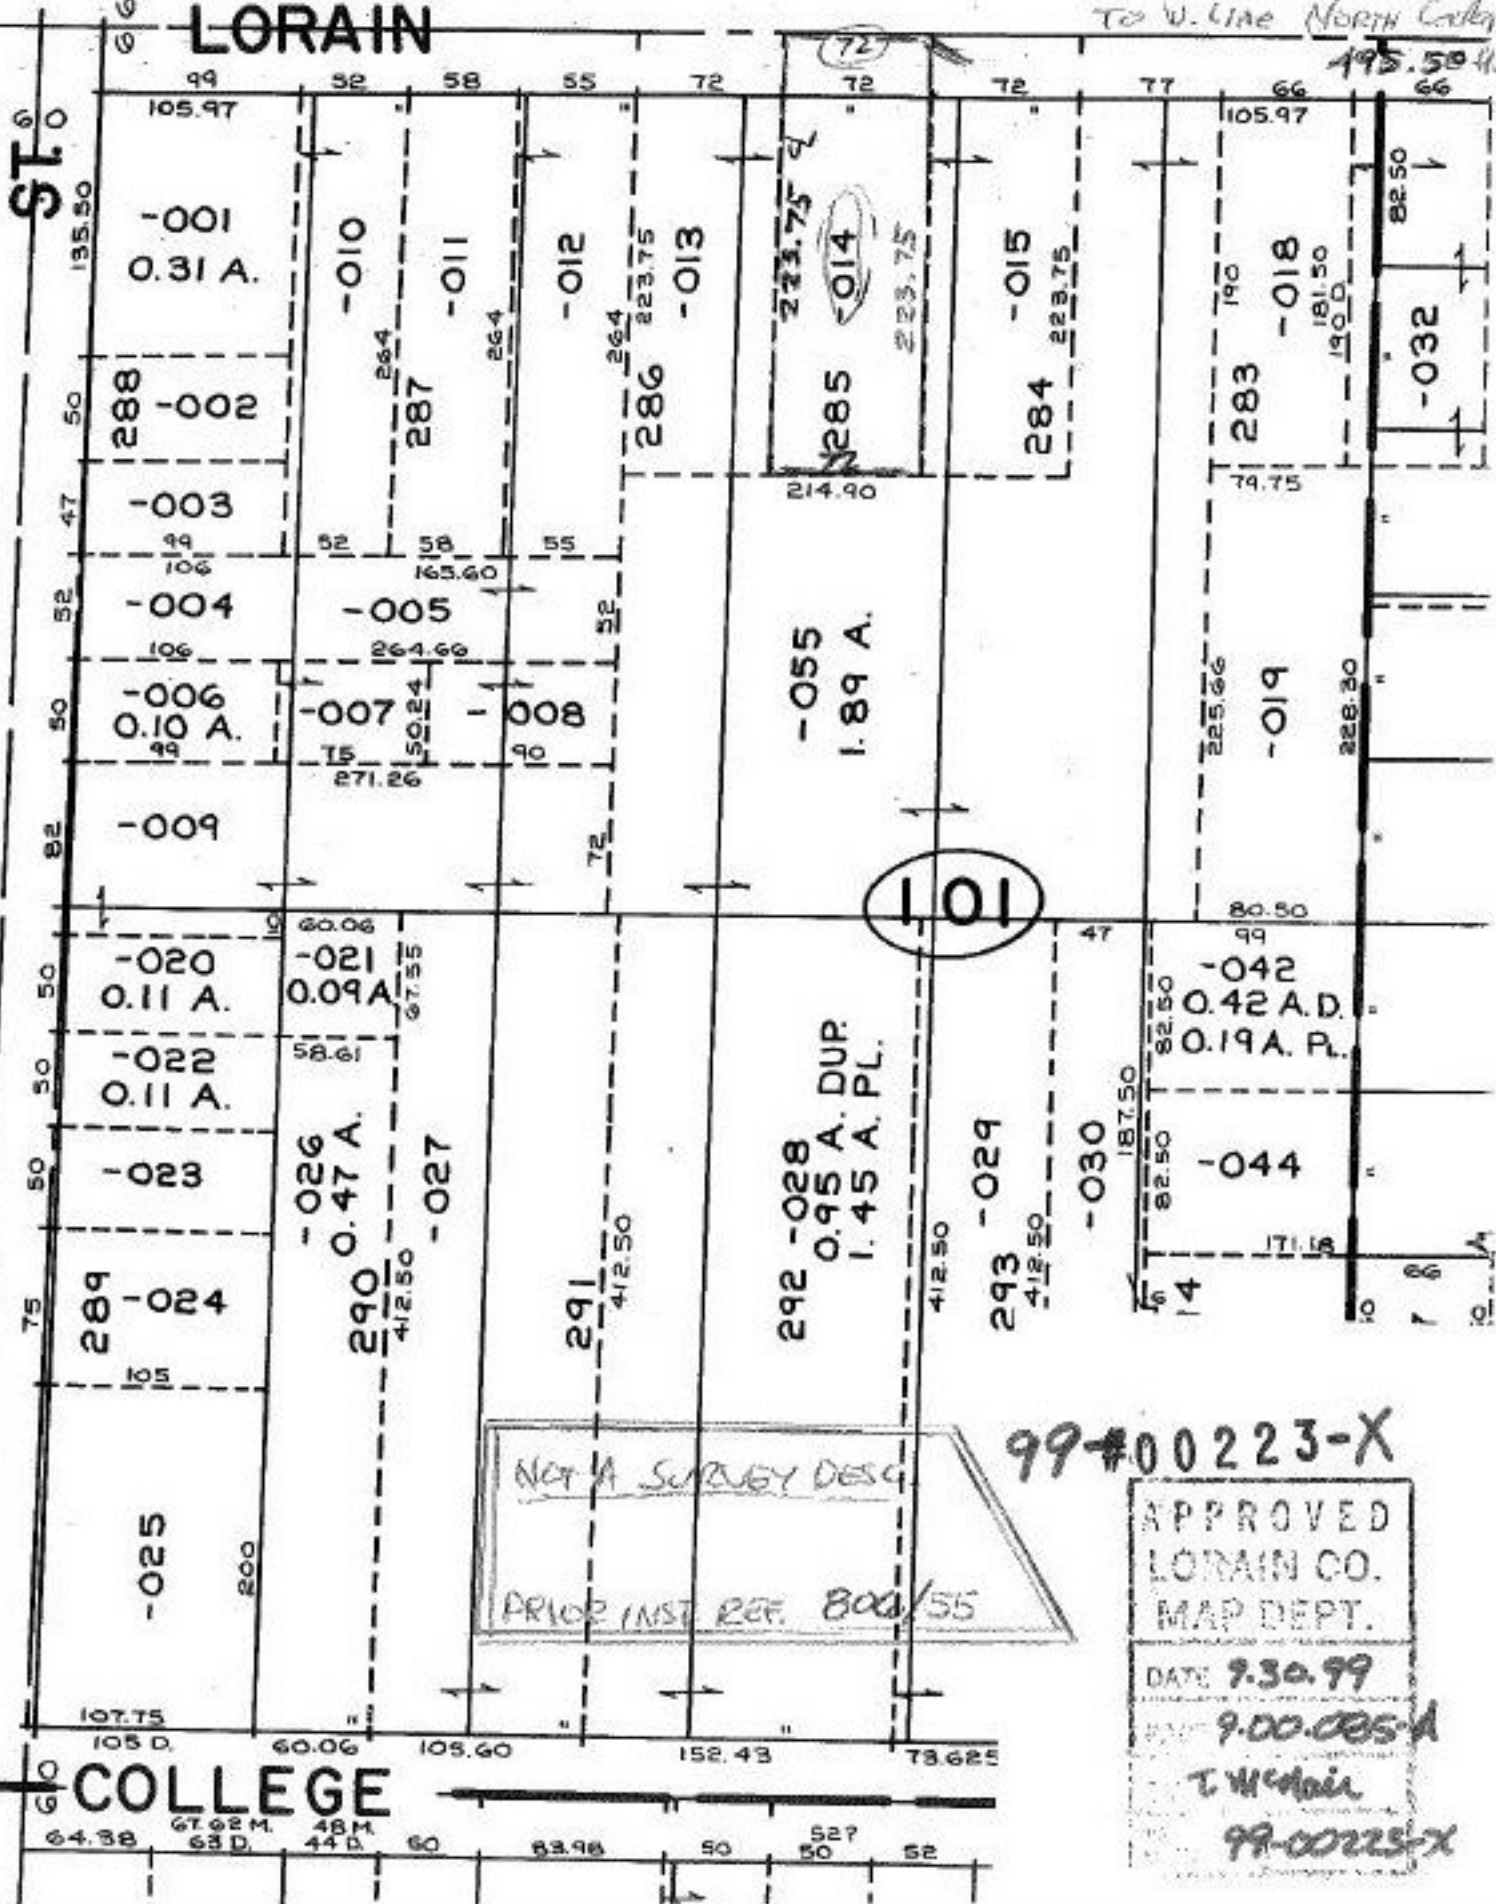

# COLLEGE

99-00223-X

APPROVED  
 LORAIN CO.  
 MAP DEPT.  
 DATE 9.30.99  
 PART 9.00.005-A  
 T. McNeil  
 99-00223-X