

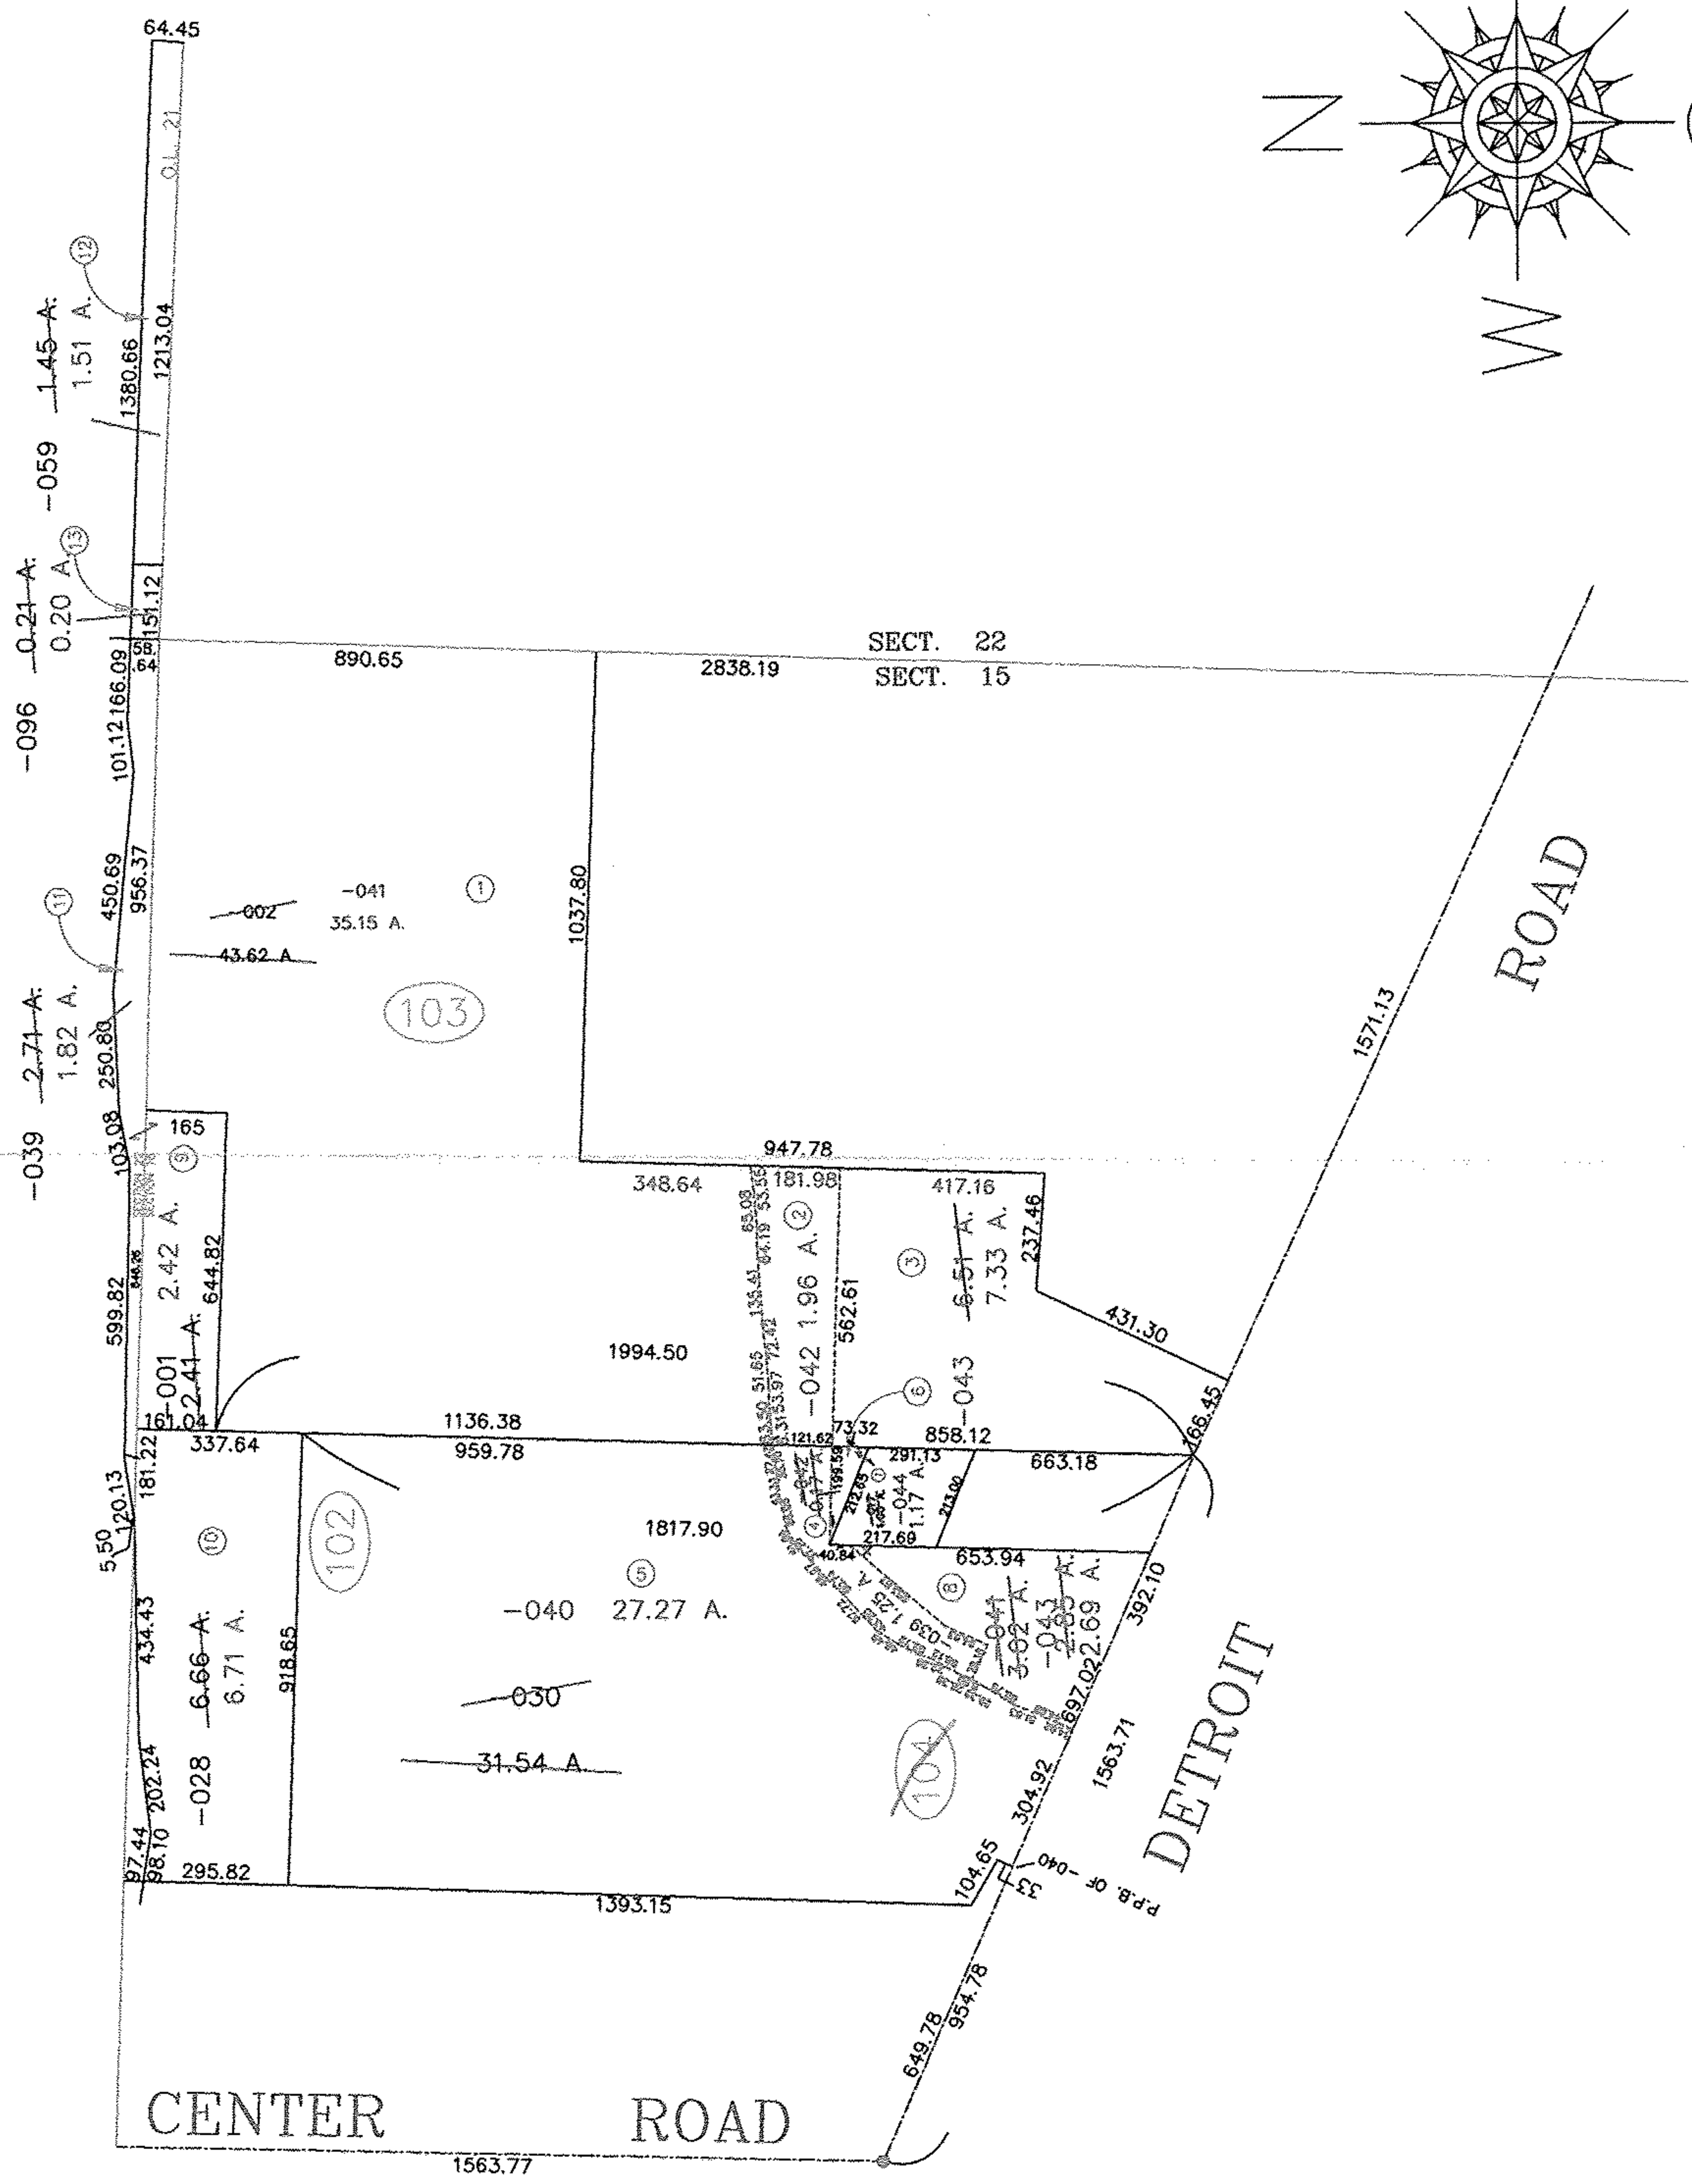


PARENT PARCEL: 04-00-015-102-017, -028, -030, 04-00-015-103-001, -002, -04-00-016-104-039
 04-00-021-000-059, -096
 CHILD PARCEL: 05-00-015-102-039, -041, -042, -043, -044, 04-00-015-103-041, -042, -043
 STARTING POINT: INT CL CENTER ROAD AND DETROIT ROAD

NO. 00228

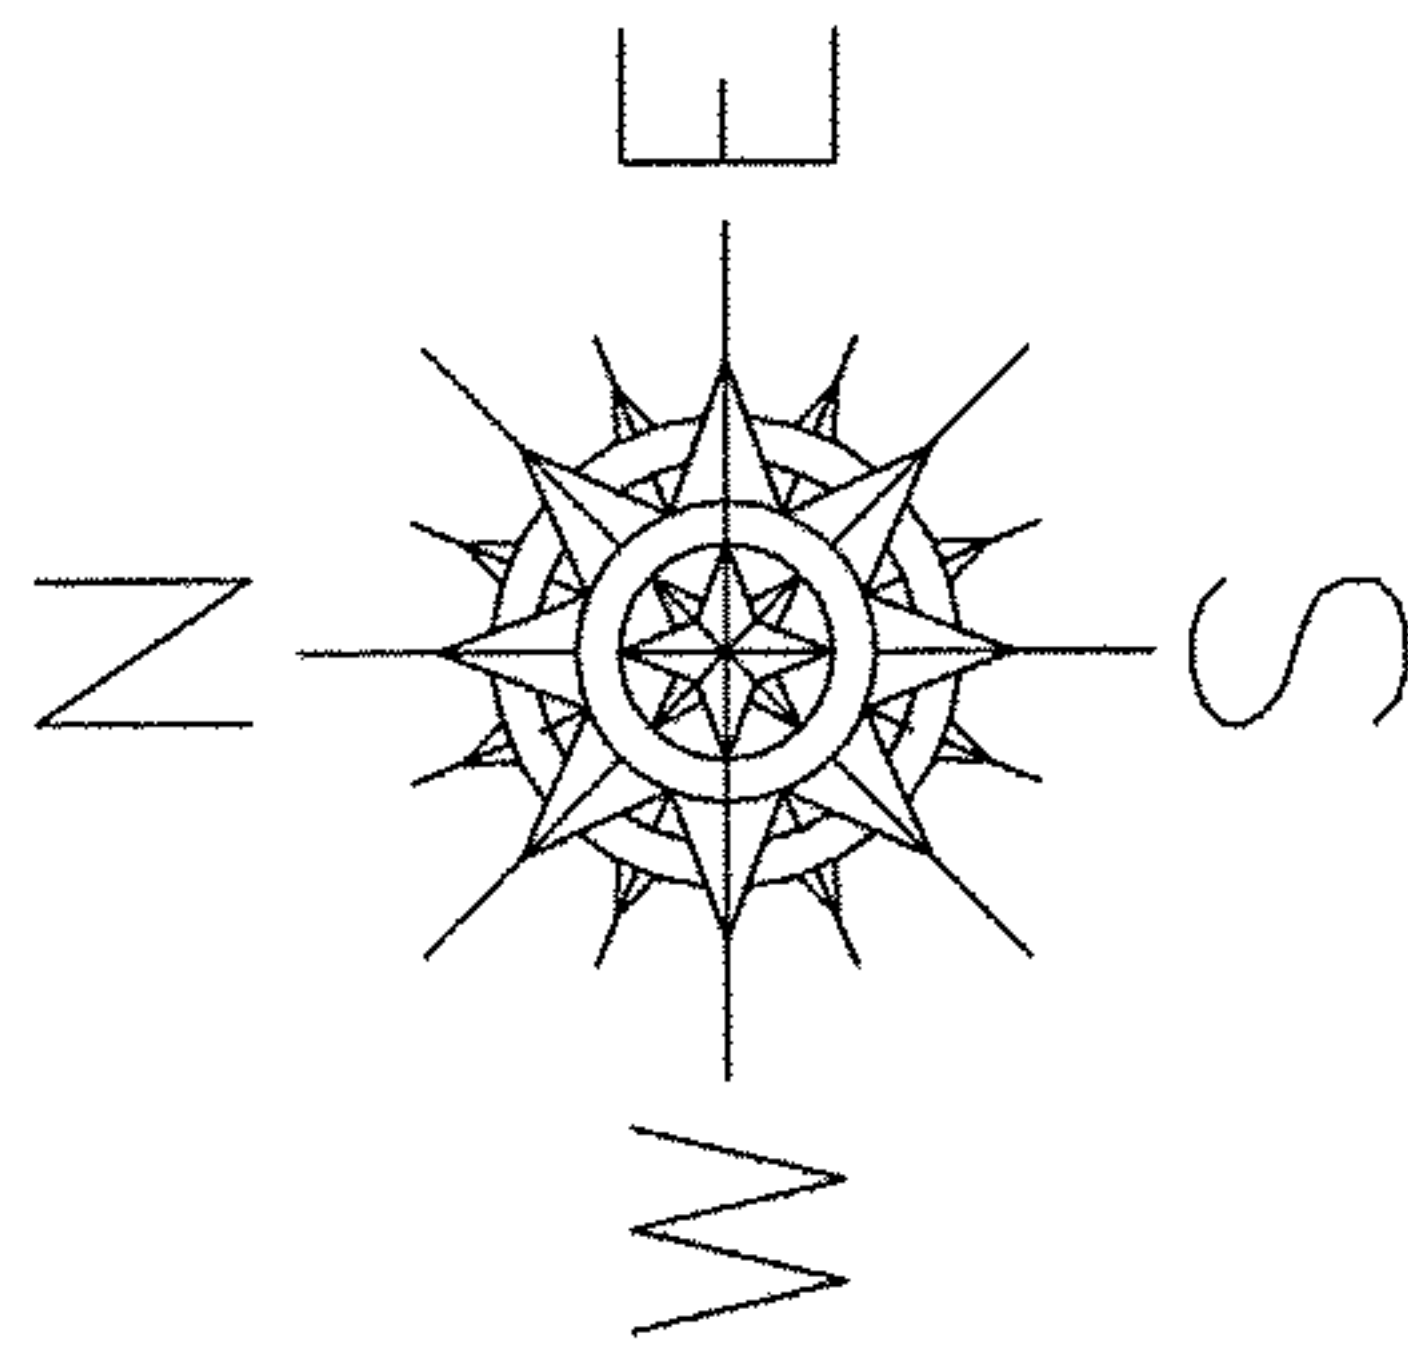

PRIOR INSTRUMENT: OR 850/320
 PRIOR INSTRUMENT: OR 1426/262

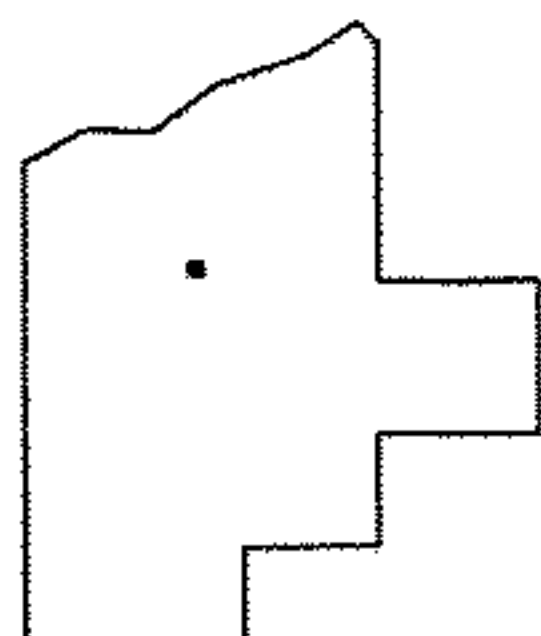

SPLITS/DEEDS PROCESSED
 LORAIN COUNTY TAX MAP DEPARTMENT
 226 MIDDLE AVE. ELYRIA, OHIO

SURVEYED BY: NEFF AND ASSOCIATES
 CLOSURE: 0.11 : 10,000
 MAP PAGE(S): 4-G, 04-00-015-C, 04-00-015-D, 04-00-016-G
 APPROVED BY: DRH DATE: 10/27/99
 SCALE: 1" = 400'