

PARENT PARCEL: 21-05-028-000-008 & 21-05-029-000-013

CHILD PARCEL: XX-XX-XXX-XXX-XXX

STARTING POINT: R.R.S., CL OF BURSLEY RD. & S.E. CORNER OF O.L. 28

NO. 00229-A

ACREAGE CORRECTION

21-05-028-000-008

~~27.50 A.~~


27.81 A.

21-05-029-000-013

~~15.15 A.~~

15.11 A.

AC. CORR. PER SURV.
RODGER G. SIMON

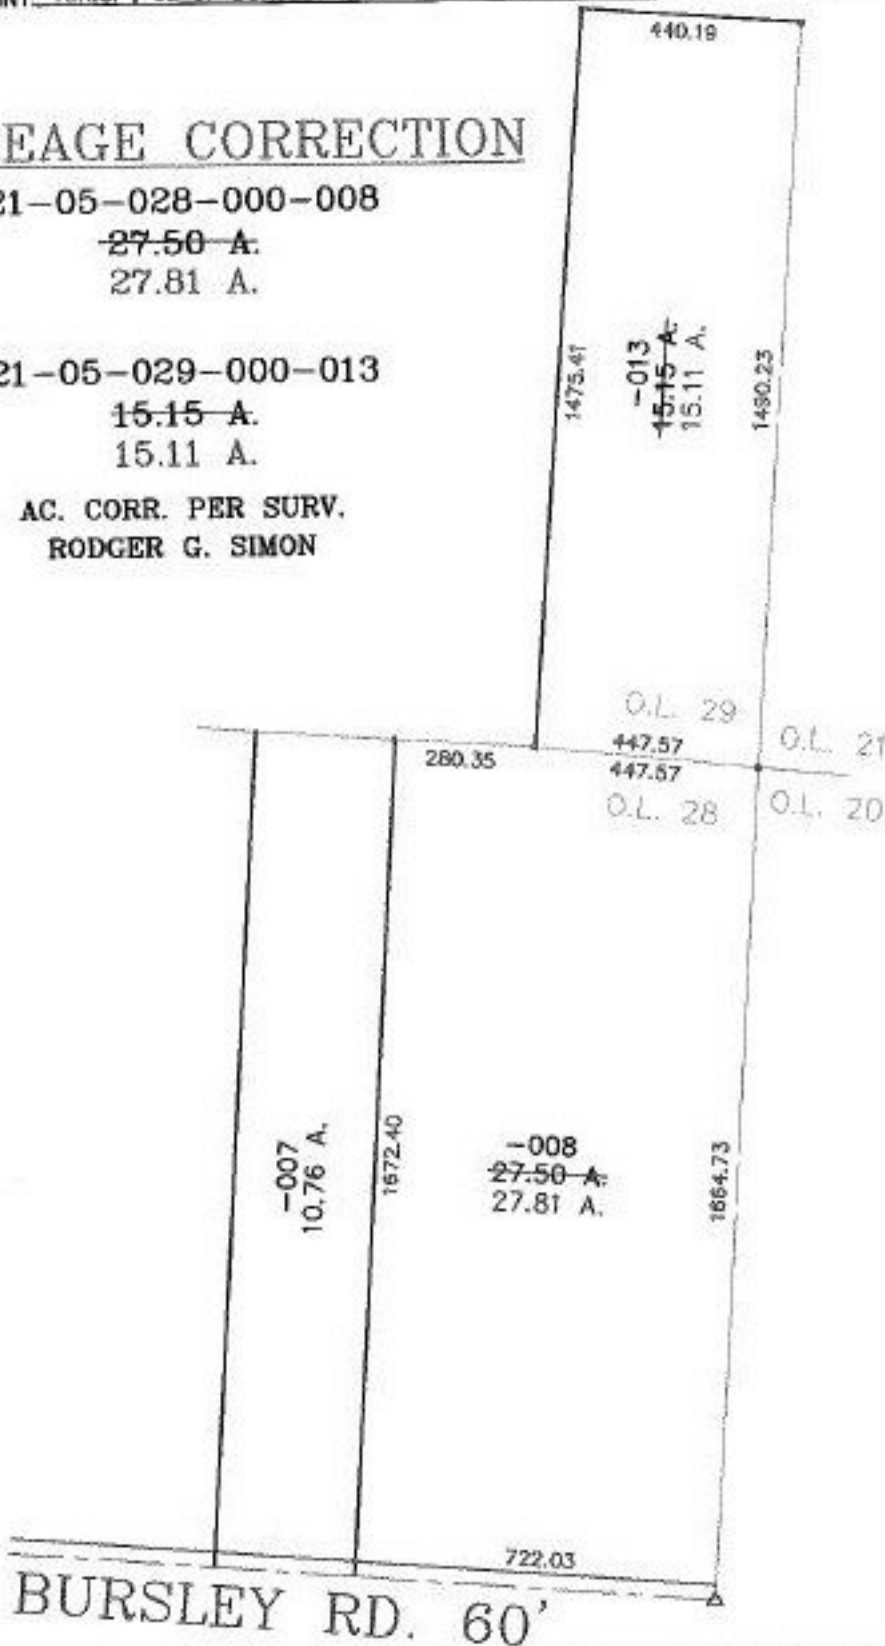

RS
2-21-00

PRIOR INSTRUMENT: DV 365/209

PRIOR INSTRUMENT: DV 286/317



SPLITS/DEEDS PROCESSED

LORAIN COUNTY TAX MAP DEPARTMENT
226 MIDDLE AVE. ELYRIA, OHIO

SURVEYED BY: RODGER G. SIMON

CLOSURE: 0.02 : 10,000

MAP PAGE(S): 21-A

APPROVED BY: T. SPILLMAN DATE: 11/08/99

SCALE: 1" = 400'