

PARENT PARCEL: 02-00-093-105-007

CHILD PARCEL: XXXXXXXXXXXXX

STARTING POINT: I.P. S.W. CORNER OF S\1 20 IN THE O. ROOT TRUSTEE'S ADDITION

NO. 00230-D

FRONTAGE & DEPTH CORRECTION


02-00-093-105-007

~~35.16 X 100~~

36.37 X 110.97

CORR. PER SURV.

DANIEL J. HOUCK

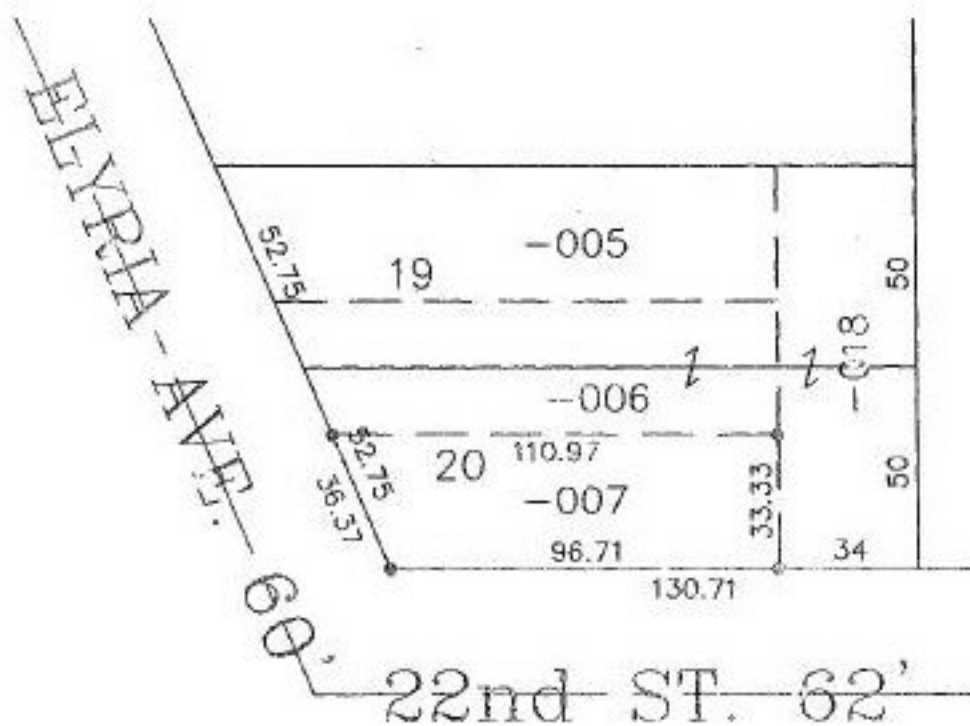

SURVEYED BY: DANIEL J. HOUCK

CLOSURE: 0.15 : 10.000

MAP PAGE(S): 02-00-093-B

APPROVED BY: I. SPILLMAN DATE: 11/10/99

SCALE: 1" = 50' PRIOR INSTRUMENT: 970500173

SPLITS/DEEDS PROCESSED

LORAIN COUNTY TAX MAP DEPARTMENT
226 MIDDLE AVE. ELYRIA, OHIO