

PARENT PARCEL: 05-00-029-000-075 & -076

CHILD PARCEL: 05-00-029-000-085 & -086

STARTING POINT: I.P. MON. BOX, CL OF MILAN-ELYRIA RD. & THE EAST LINE OF O.L. 29

NO. 00232-X

PARCEL NUMBER CORRECTION

05-00-029-000-085


~~05-00-029-000-075~~

0.11 A.

05-00-029-000-086

~~05-00-029-000-076~~

1.84 A.

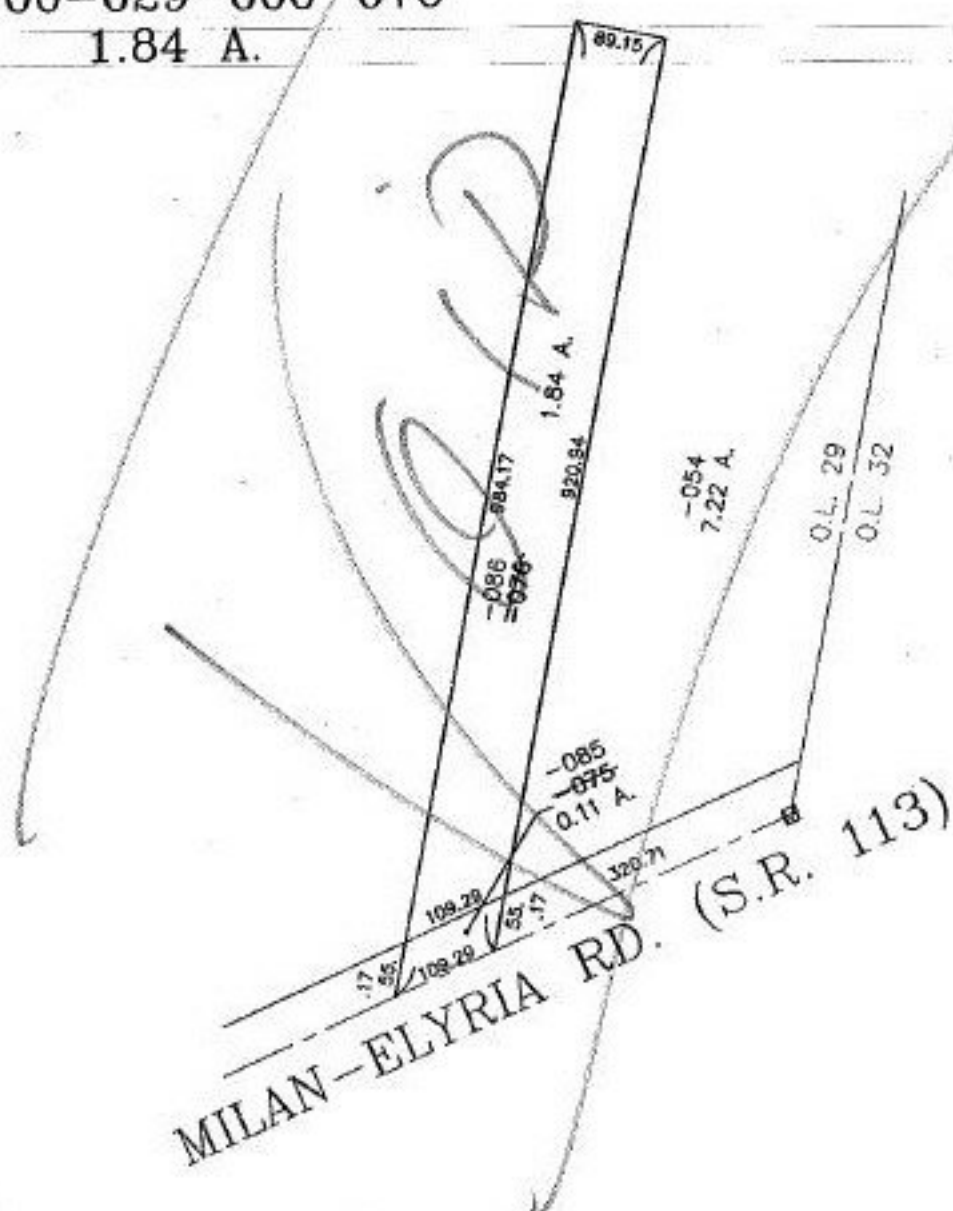

SPLITS/DEEDS PROCESSED
LORAIN COUNTY TAX MAP DEPARTMENT
226 MIDDLE AVE. ELYRIA, OHIO

SURVEYED BY: JAMES E. KENYON (STATE OF OHIO)
CLOSURE: 0.00 : 10.000
MAP PAGE(S): 05-00-029-B
APPROVED BY: I. SPILLMAN DATE: 10/29/99
SCALE: 1" = 200' PRIOR INSTRUMENT: 970496361