

PARENT PARCEL: 11-00-076-000-023

CHILD PARCEL: XX-XX-XXX-XXX-XXX

STARTING POINT: CL OF DURKEE RD. & SOUTH LINE OF O.L. 76

NO. 00233-A

ACREAGE CORRECTION


11-00-076-000-023

~~10.00 A.~~


10.19 A.

AC. CORR. PER SURV.

JOHN POZYWAK

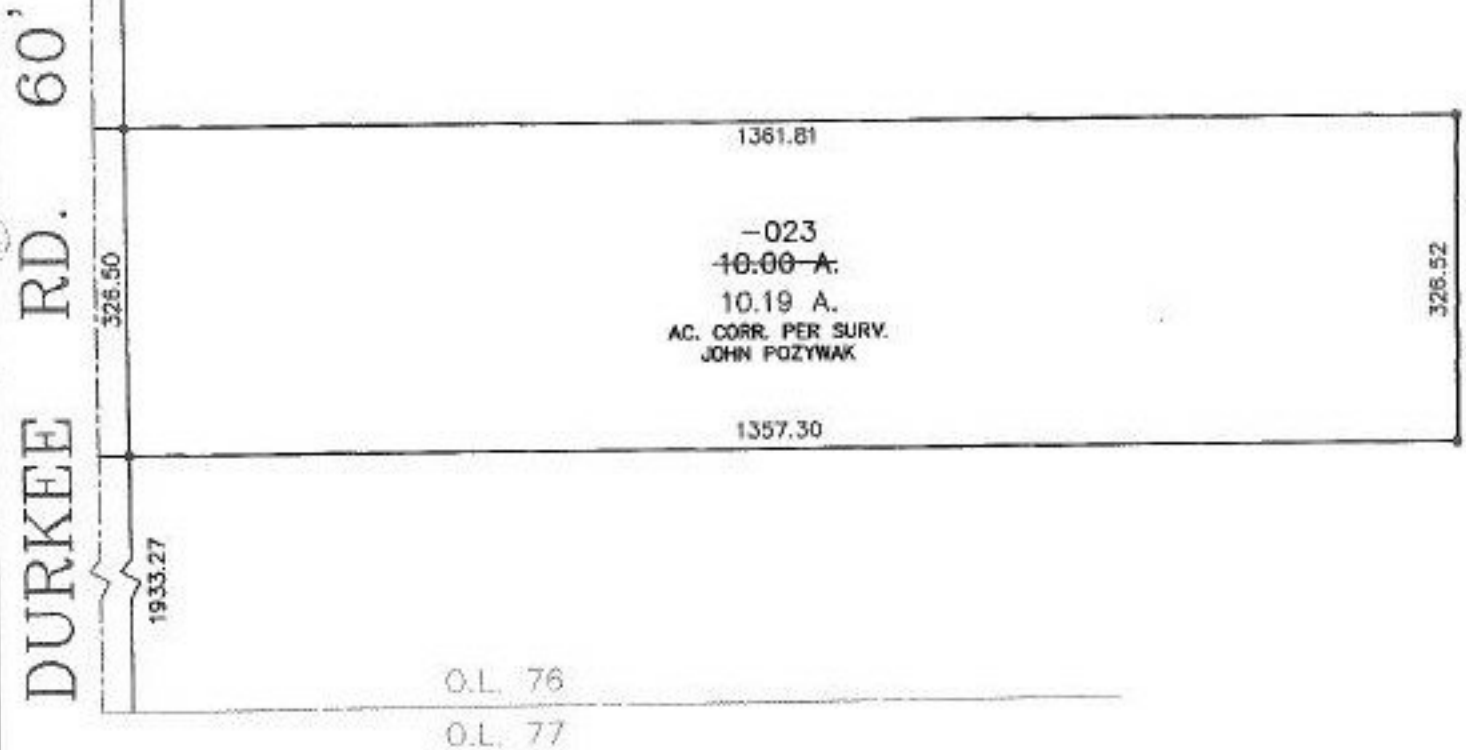

TS
2-17-00

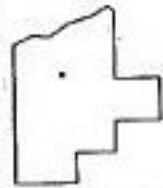

SPLITS/DEEDS PROCESSED
LORAIN COUNTY TAX MAP DEPARTMENT
226 MIDDLE AVE. ELYRIA, OHIO

SURVEYED BY: JOHN POZYWAK
 CLOSURE: 0.15 : 10.000
 MAP PAGE(S): 11-00-076-A
 APPROVED BY: J. SPILLMAN DATE: 10/27/99
 SCALE: 1" = 200' PRIOR INSTRUMENT: OR 275/468