

PARENT PARCEL: 04-00-015-101-055

CHILD PARCEL: XX-XX-XXX-XXX-XXX

STARTING POINT: MON. BOX, CL OF WOOSTER-AVON LAKE RD. & CL OF NORTH RIDGE RD.

NO. 00234-A

ACREAGE CORRECTION


04-00-015-101-055

~~1.71 A.~~

1.38 A.



AC. CORR. PER SURV.
GUTOSKEY & ASSOC.

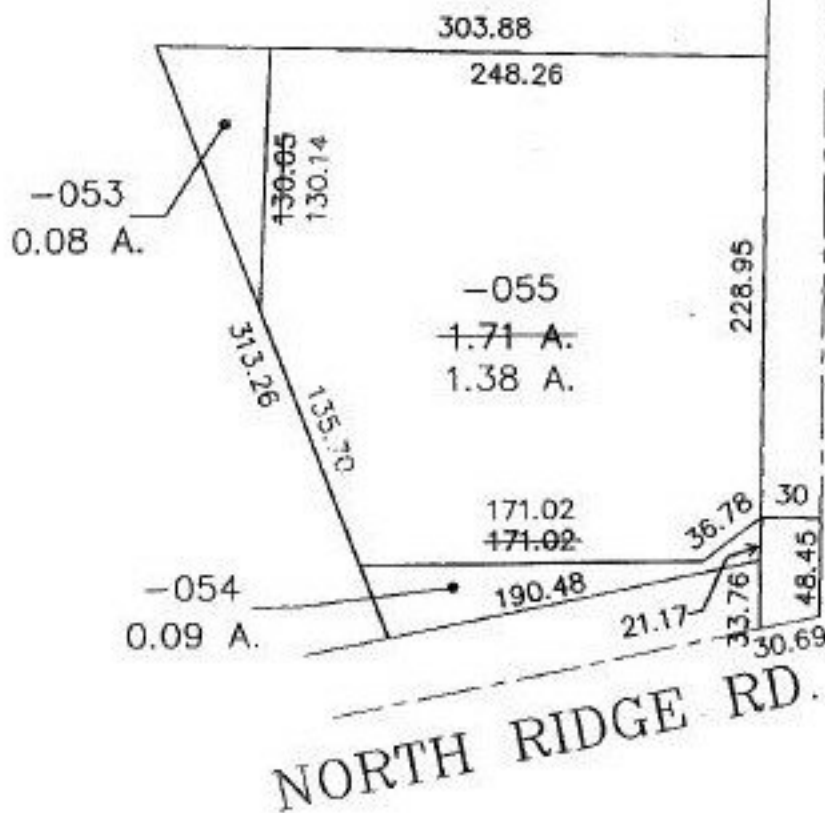

SPLITS/DEEDS PROCESSED

LORAIN COUNTY TAX MAP DEPARTMENT
226 MIDDLE AVE. ELYRIA, OHIO

SURVEYED BY: GUTOSKEY & ASSOC.

CLOSURE: 0.08 : 10,000

MAP PAGE(S): 04-00-015-B

APPROVED BY: T. SPILLMAN DATE: 11/01/99

SCALE: 1" = 100' PRIOR INSTRUMENT: 990625942