


PARENT PARCEL: 16-00-066-000-009

CHILD PARCEL: 16-00-066-000-034, -035

STARTING POINT: MON BOX SW CORNER O.L. 66 (INT CL OF LAW ROAD AND AVON BELDON RD)

NO. 00235

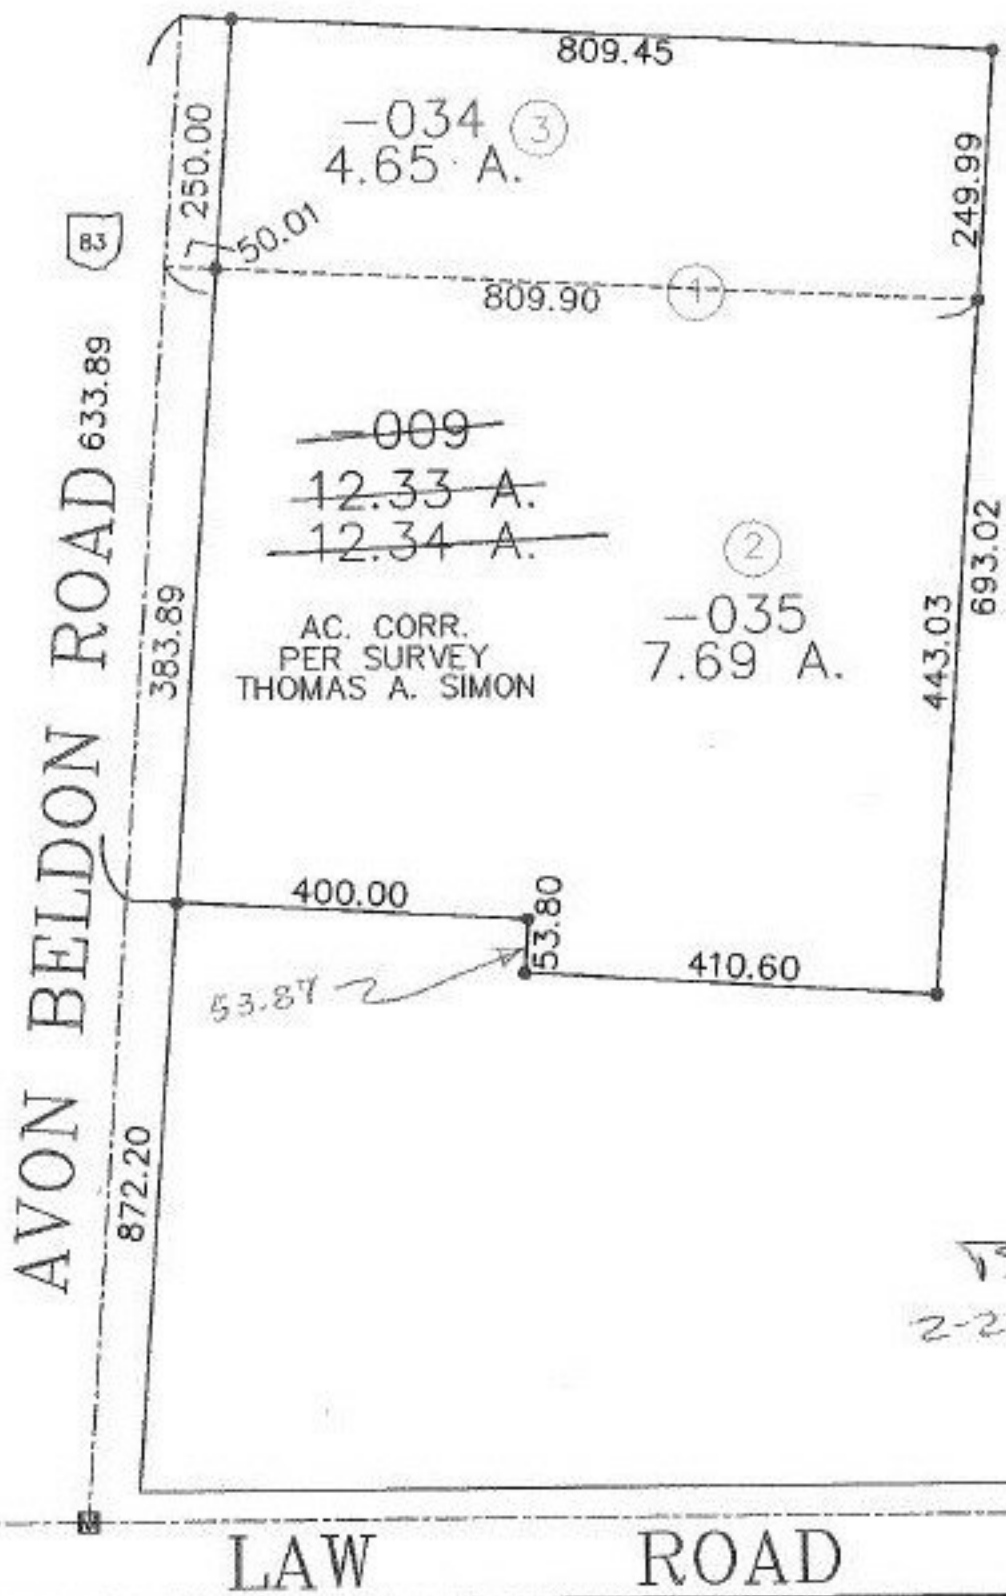

AVON BELDON ROAD 633.89

LAW ROAD

TS  
2-22-00

SPLITS/DEEDS PROCESSED

LORAIN COUNTY TAX MAP DEPARTMENT  
226 MIDDLE AVE. ELYRIA, OHIO

SURVEYED BY: THOMAS SIMON  
 CLOSURE: 0.02 : 10,000  
 MAP PAGE(S): 16-G  
 APPROVED BY: DRH DATE: 10/27/99  
 SCALE: 1" = 200' PRIOR INSTRUMENT: DV 1755/611