


PARENT PARCEL: 08-13-020-000-030

CHILD PARCEL: 08-13-020-000-037, -038, -039

STARTING POINT: MON BOX INT NORTH LINE O.L. 20 AND CL WARD RD

NO. 00238

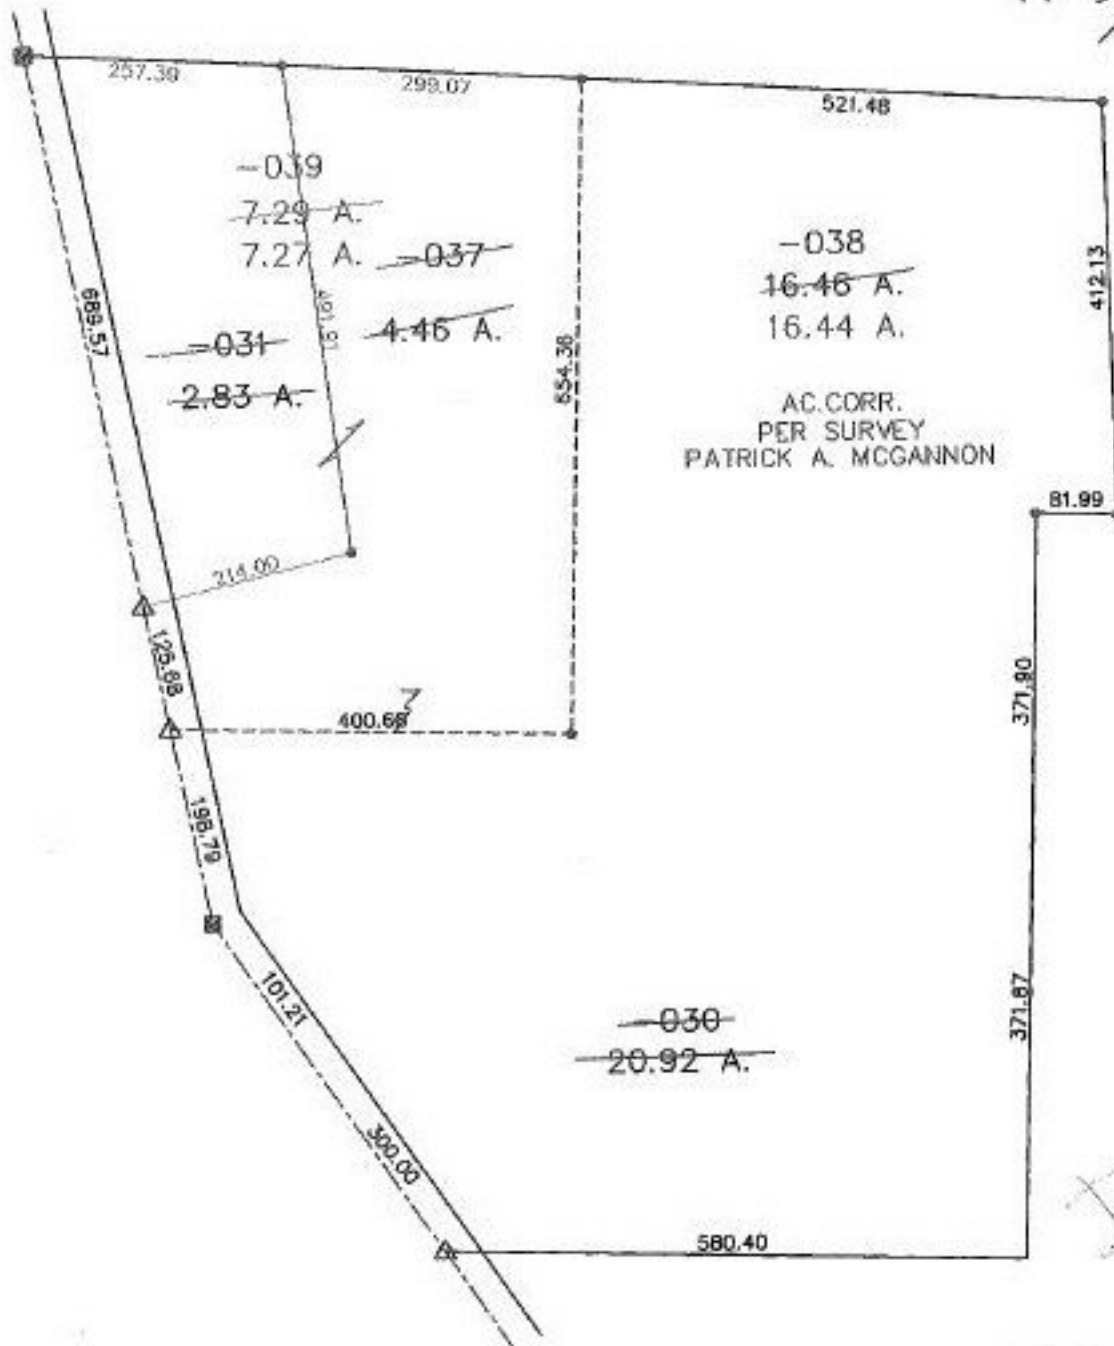

PRIOR INSTRUMENT: #980574121

PRIOR INSTRUMENT: DV 86/814



SPLITS/DEEDS PROCESSED

LORAIN COUNTY TAX MAP DEPARTMENT
226 MIDDLE AVE. ELYRIA, OHIO

SURVEYED BY: PATRICK A. MCGANNON

CLOSURE: 0.01 : 10.000

MAP PAGE(S): 8-F

APPROVED BY: DRH DATE: 8/22/99

SCALE: 1" = 200'