


PARENT PARCEL: 05-00-040-106-124

CHILD PARCEL: 05-00-040-106-125, -126

STARTING POINT: INT SR 58 AKA LEAVITT RD AND SL O.L. 40

NO. 00240

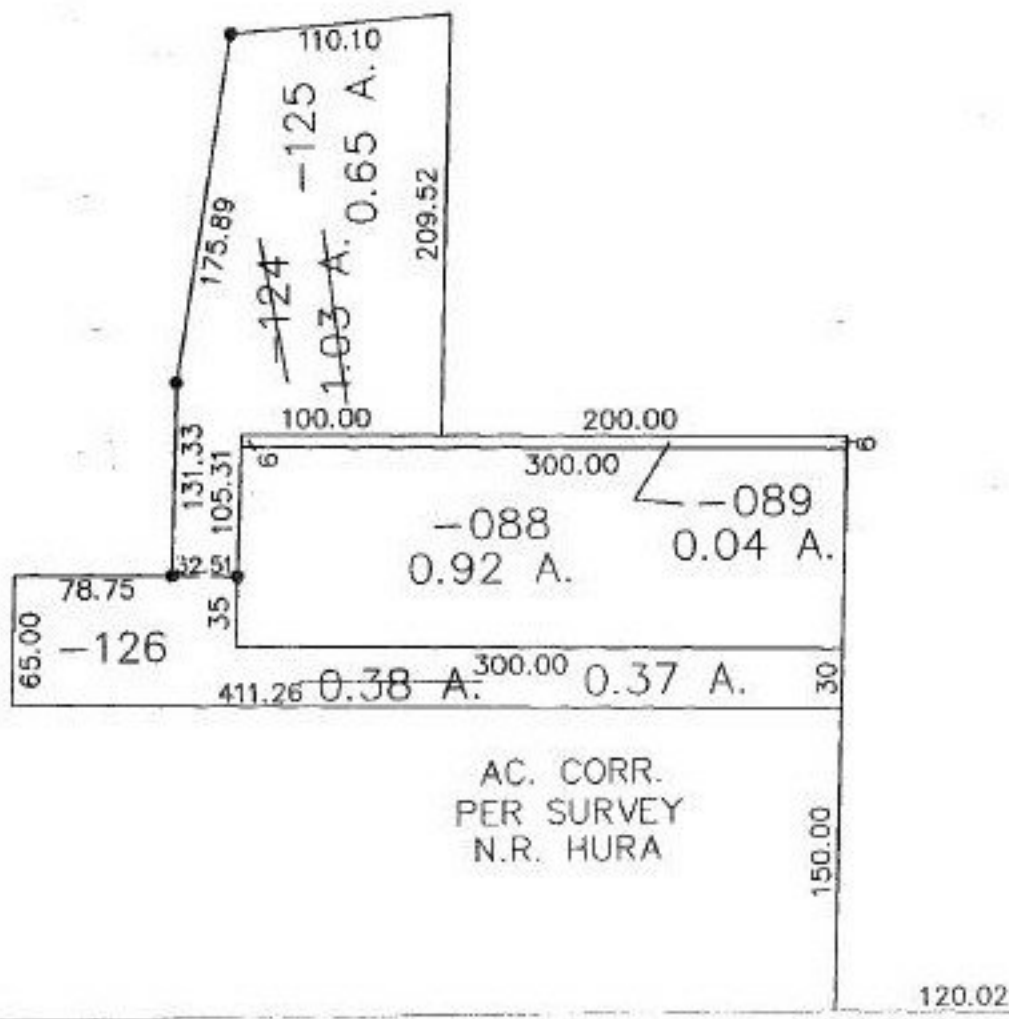

ROAD



LEAVITT

**SPLITS/DEEDS PROCESSED**

LORAIN COUNTY TAX MAP DEPARTMENT  
226 MIDDLE AVE. ELYRIA, OHIO

SURVEYED BY: N.R. HURA

CLOSURE: 0.00 ; 10,000

MAP PAGE(S): 05-00-040-B

APPROVED BY: DRH DATE: 10/15/99

SCALE: 1" = 100' PRIOR INSTRUMENT: #980549456