

PARENT PARCEL: 11-00-070-000-058


CHILD PARCEL: XX-XX-XXX-XXX-XXX

STARTING POINT: CL OF BUTTERNUT RIDGE RD. & N.E. CORNER OF LAND CONVEYED TO SINGER

NO. 00241-A



2-28-00
AM

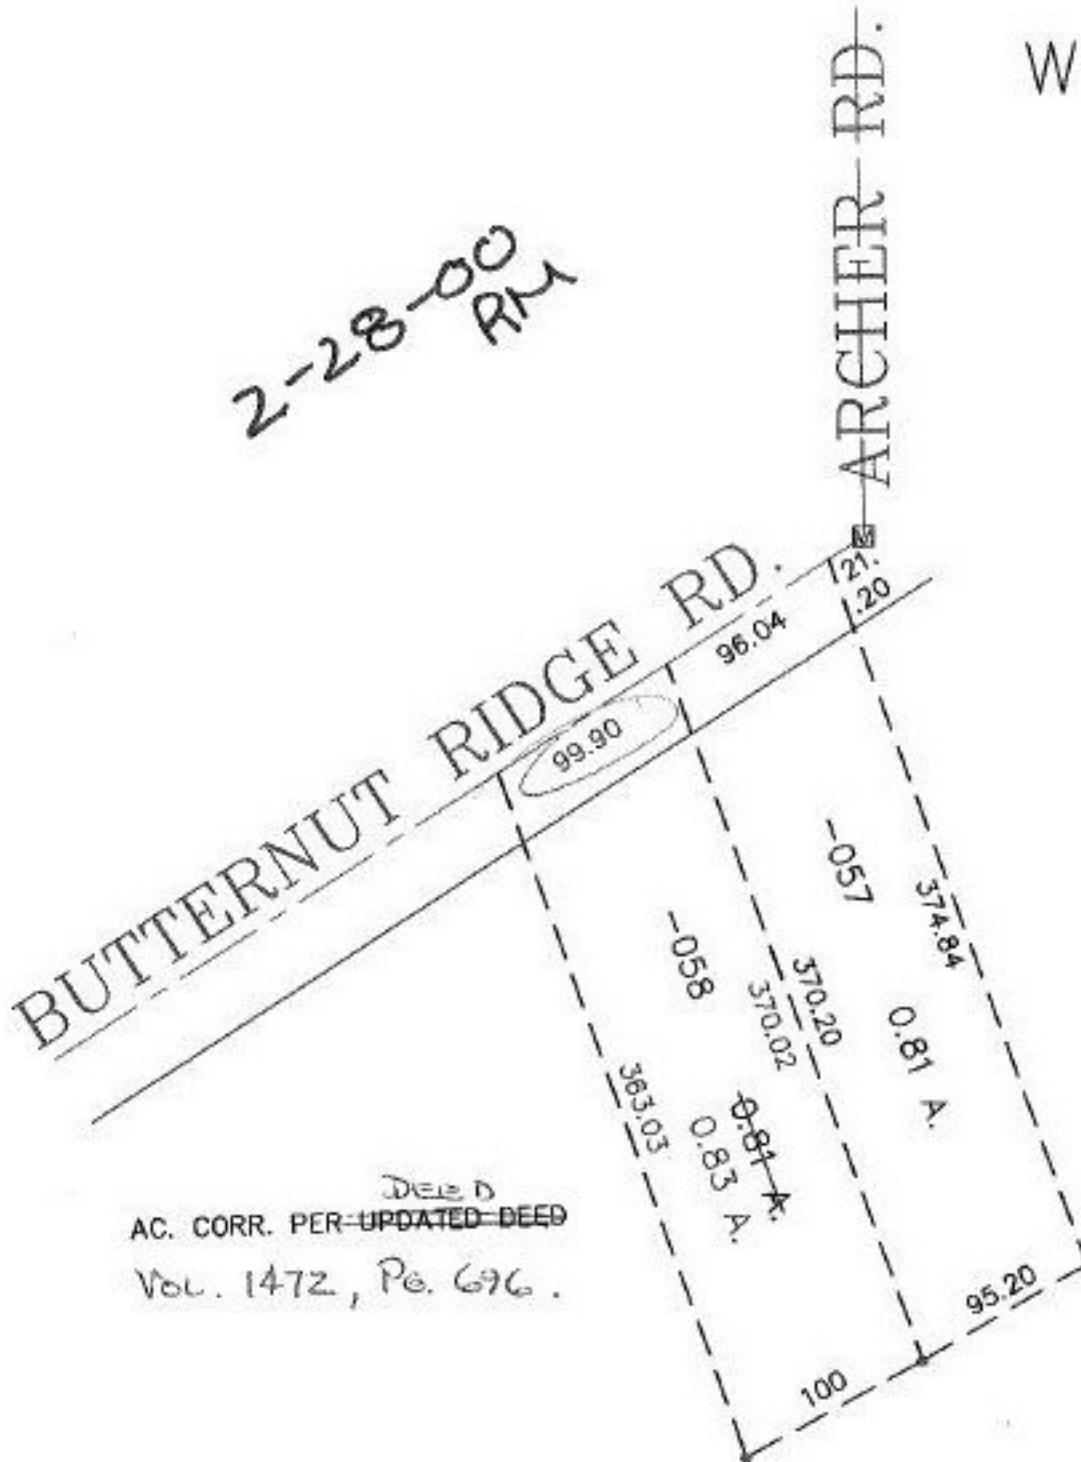

DEED D
AC. CORR. PER-UPDATED-DEED
Vol. 1472, Pg. 696.

T3
4-5-00

2/28/2000
JS



SPLITS/DEEDS PROCESSED

LORAIN COUNTY TAX MAP DEPARTMENT
226 MIDDLE AVE. ELYRIA, OHIO

SURVEYED BY: NONE
CLOSURE: 0.21 : 10.000
MAP PAGE(S): 11-00-070-A
APPROVED BY: J. SPILLMAN DATE: 01/21/00
SCALE: 1" = 100' PRIOR INSTRUMENT: DV 1472/696